


T 18 S R 6 W WM

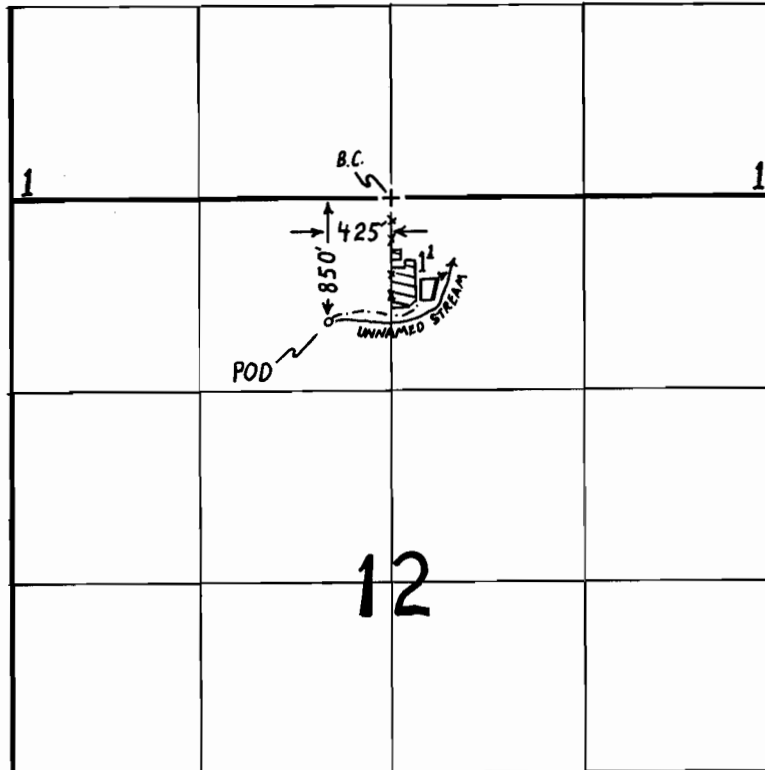

FINAL PROOF SURVEY
UNDER

R-65154 R-8891
Application No. 65155 Permit No. 47833....
IN NAME OF

.....LAWRENCE.....SALMONY.....

Surveyed Aug. 23, 1990, by T. M. WARREN...