


T18S R6W WM

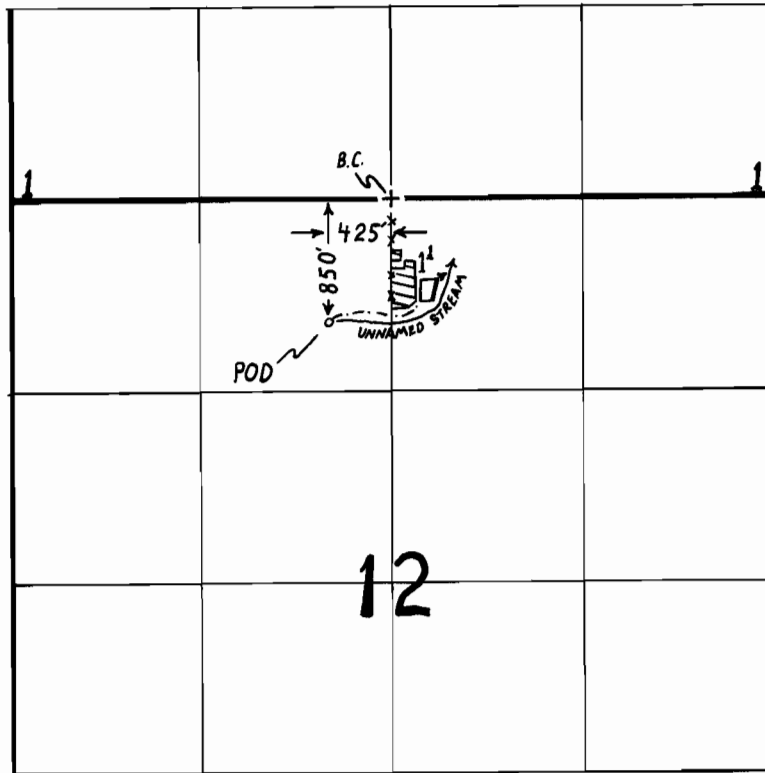

1" = 1320'

FINAL PROOF SURVEY
UNDER

R-65154 *R-8891*
Application No. *65155* Permit No. *47833*....
IN NAME OF

.....*LAWRENCE*.....*SALMONY*.....

Surveyed *Aug. 23*. 19*90*., by *T. M. WARREN*...