


T. 22. R. 5 & 6 W., W.M.

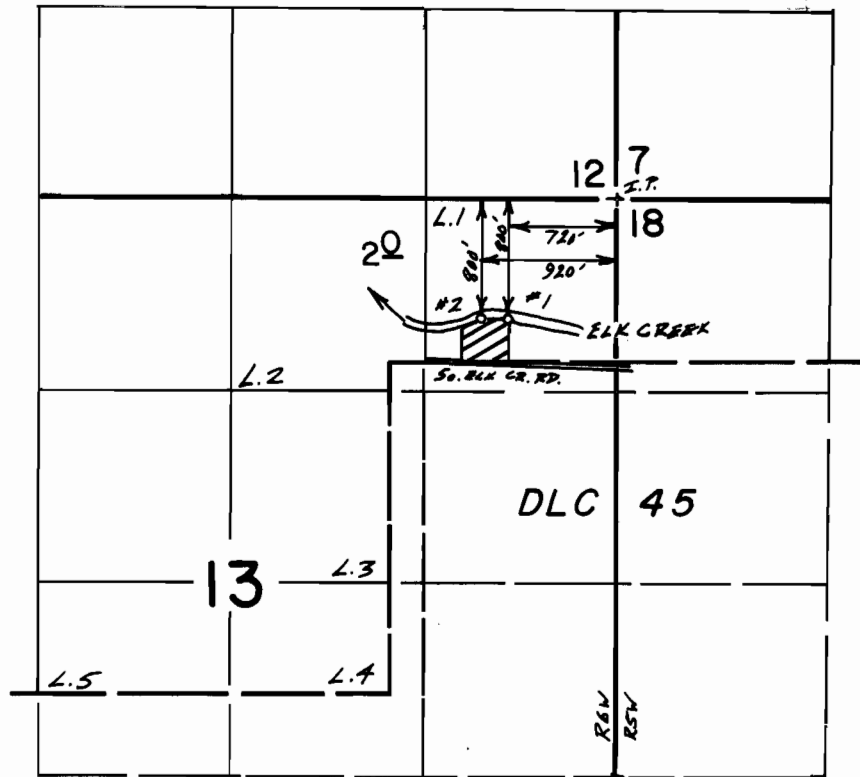

Scale 1"=1320'

FINAL PROOF SURVEY UNDER

Application No. 65329 Permit No. 47936...
IN NAME OF

.....JIMMIE H. & GAIL E. SMITH.....

Surveyed Aug. 15. 1991., by B.S. JAMES.....