


T19S R5W WM

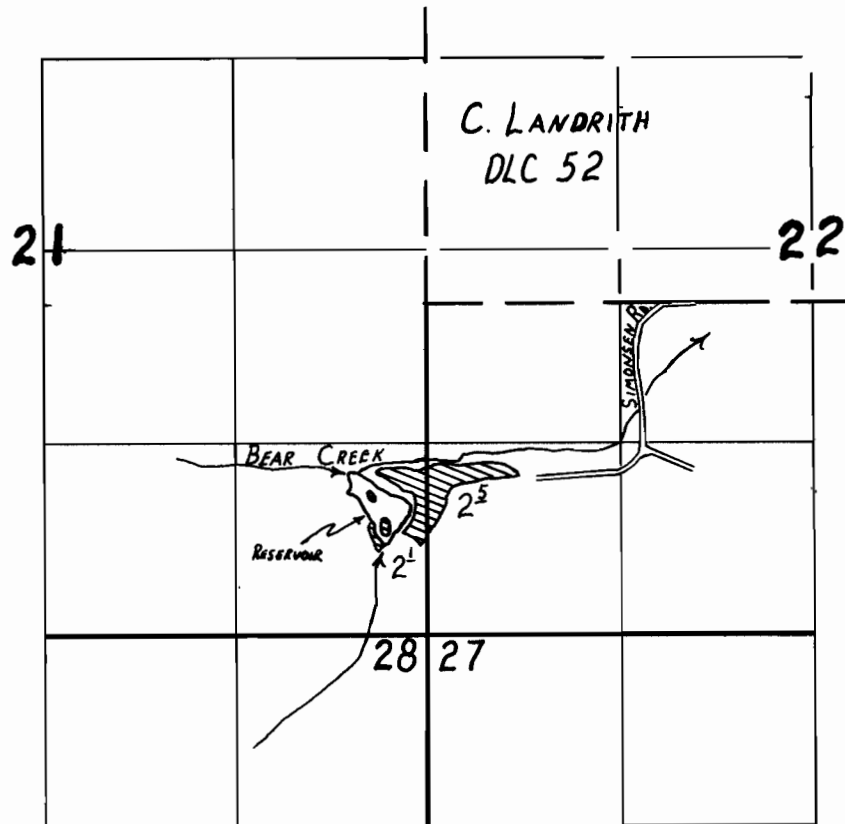

POD IS LOCATED 1090' N AND 470' W FROM THE SE CORNER SECTION 21

FINAL PROOF SURVEY
UNDER

R-66278 R-9398
Application No. 67318 Permit No. 48275....
IN NAME OF

.....CHARLES M. BORRIS.....

Surveyed AUG. 21 1990., by T.M. WARREN....