


T19S R5W WM

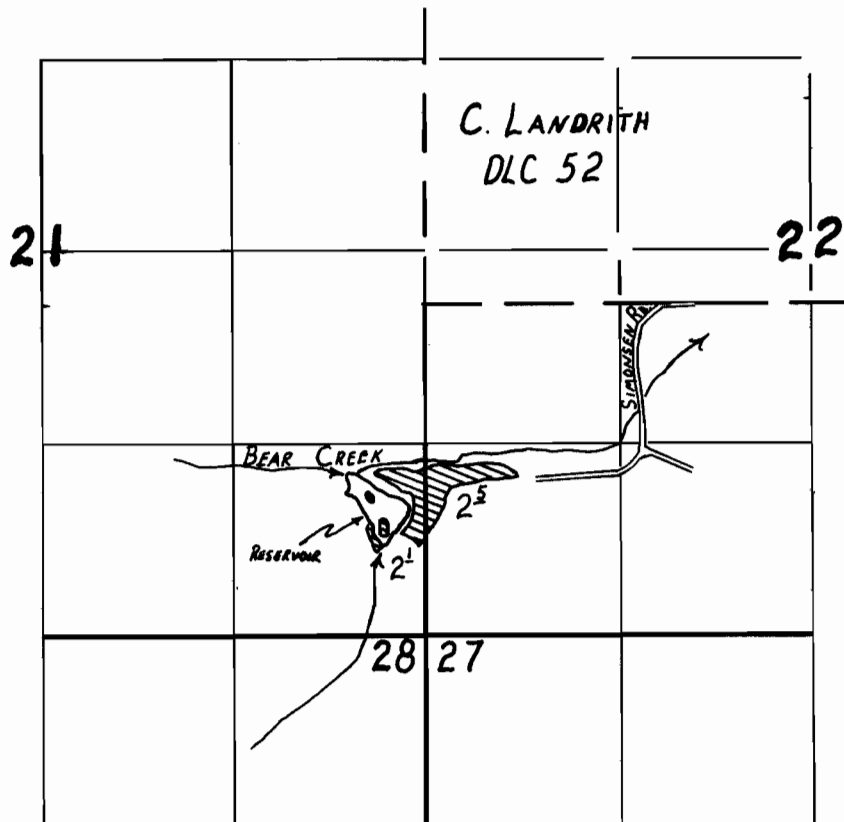

1" = 1320'

FINAL PROOF SURVEY
UNDER

R- 66278 R- 9398
Application No. 67318 Permit No. 48275....
IN NAME OF

CHARLES M. BORRIS.....

Surveyed AUG. 21 1990, by T. M. WARREN....