


T. 12 S., R. 5 W., W.M.

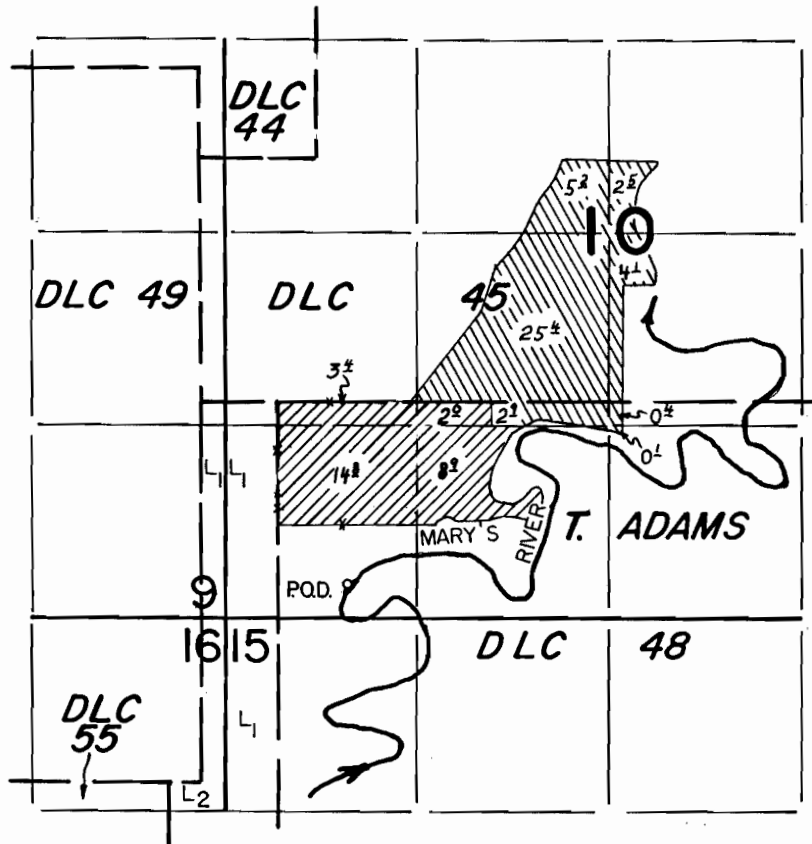

P.O.D. Loc.: 1250' S. & 470' E. from NW Cor. DLC 48.

Scale: 1" = 1320'

FINAL PROOF SURVEY UNDER

Application No. 68970 67093... Permit No. 49969 48140...
IN NAME OF

Ramon J. & Katherine Seidler

Mar 15 91 R W Klassen
Surveyed May 6 1987, by T. Warren