


T.21S., R.4W., W.M.

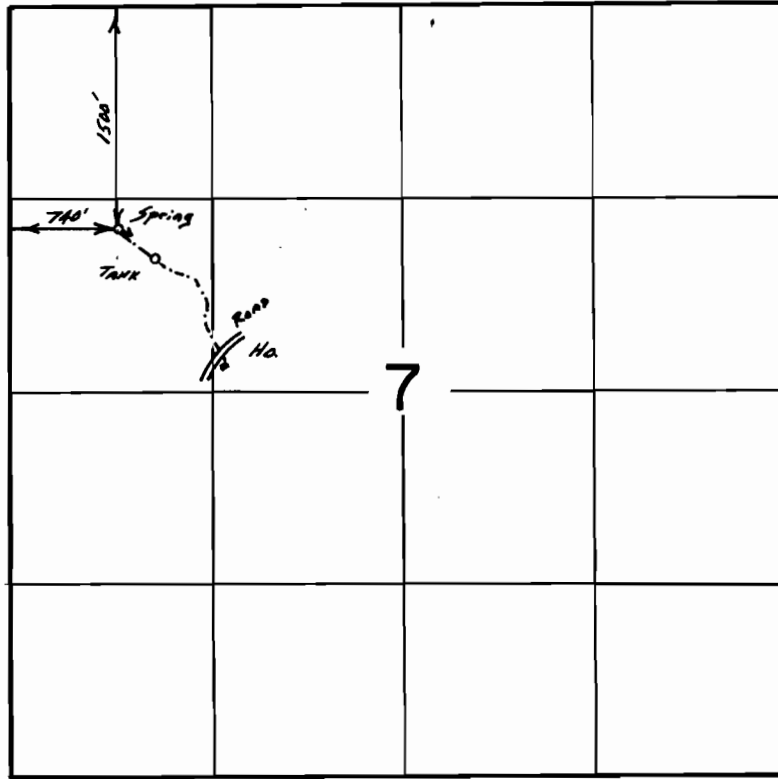

Scale 1" = 1320'

FINAL PROOF SURVEY
UNDER

Application No. 68095 Permit No. 48549...
IN NAME OF

.....ROBERT H. DAVIS.....

Surveyed Aug. 21. 1991., by R.S. JAMES.....