


T 18 S R 2 & 3 W WM

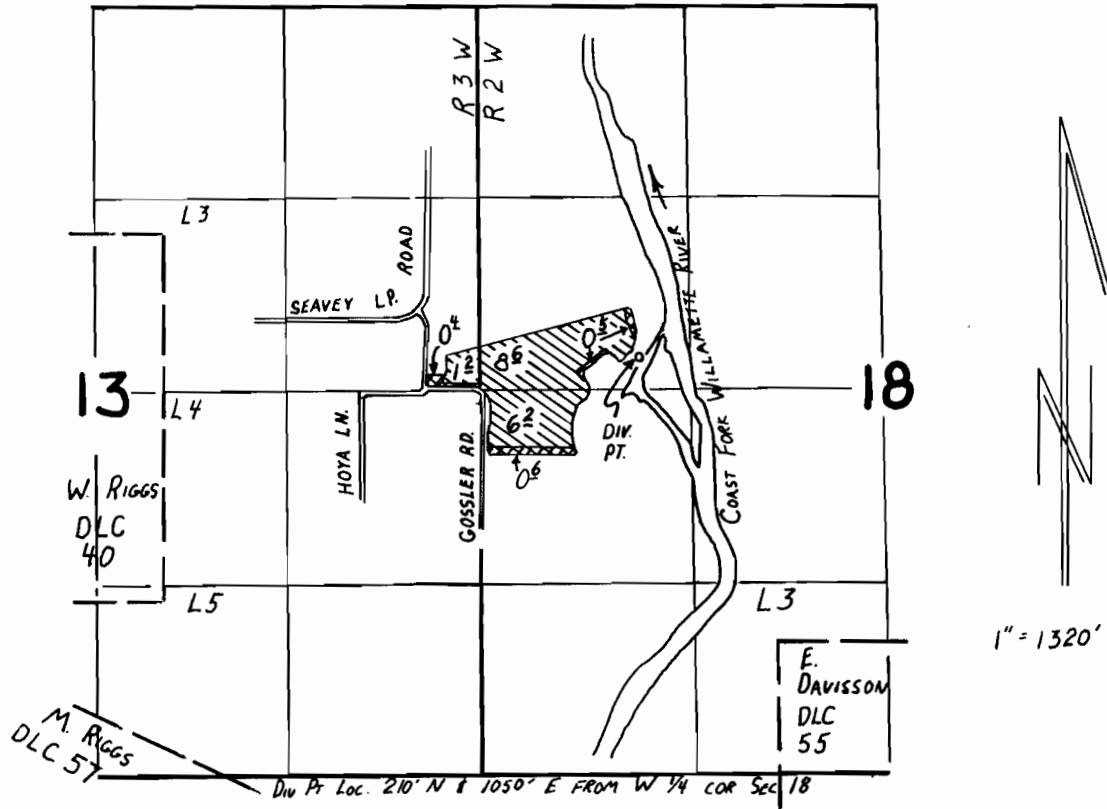

IRRIGATION 
 FROST PROTECTION 

FINAL PROOF SURVEY UNDER

Application No. 68177.. Permit No. 49398...
 IN NAME OF

.....STEVEN M. HOUSTON.....

Surveyed Aug. 28 1990, by T. M. WARREN...