



T 20S R 1W WM

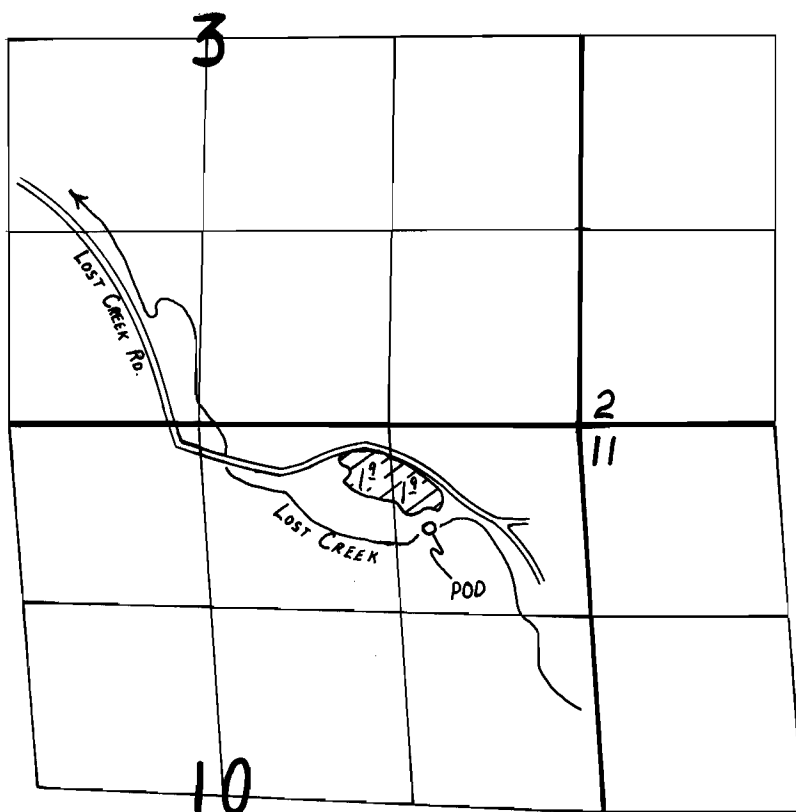

POD IS LOCATED 680' S AND 1080' W FROM THE NE CORNER
SECTION 10

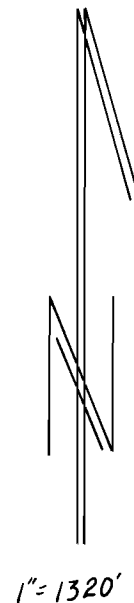

FINAL PROOF SURVEY UNDER

Application No. 68660 Permit No. 49630....
IN NAME OF

.....RITCHIEY S. POPE.....

Surveyed Aug. 20, 1990, by T. M. WARREN....