


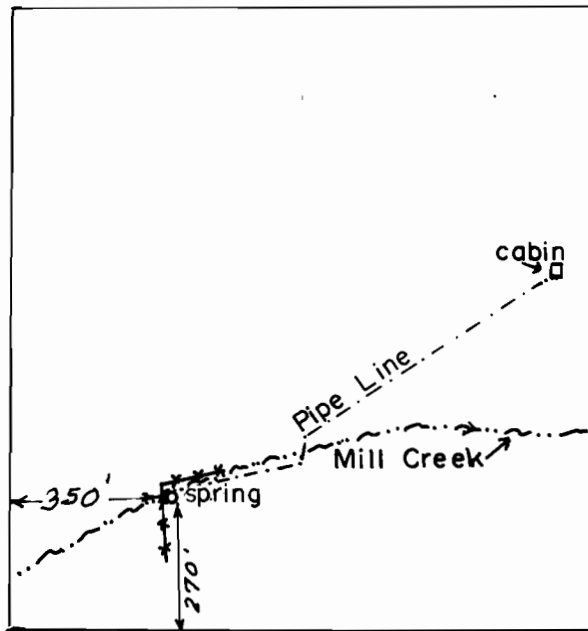

T. 9 S. R. 38 E. W. M.

SECTION 1
SE 1/4 NE 1/4

SCALE 1" = 400'



FINAL PROOF SURVEY
UNDER

Application No. **68878**. Permit No. **49944**....
IN NAME OF

.....**JOHN T. ANDERSON**.....

Surveyed **7-9** 1991., by **J. MILLER**.....