


T. 23 S., R. 7 W., W.M.

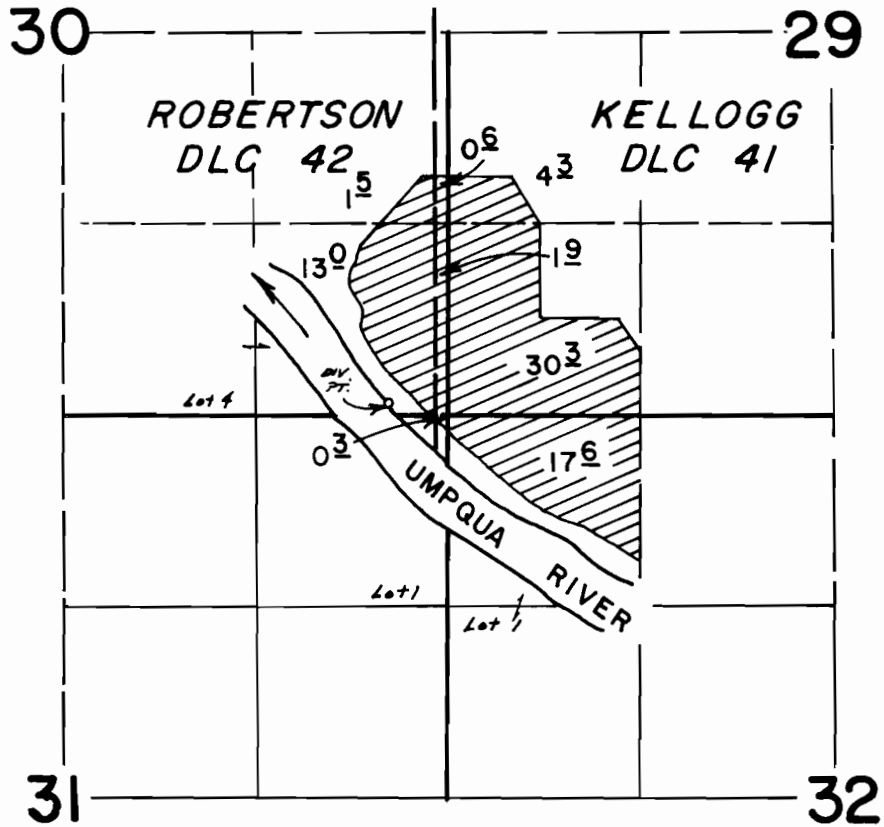

Scale 1" = 1320'

DIV. PT. : 60' N. & 410' W of SE COR. Sec. 30.

**FINAL PROOF SURVEY
UNDER**

Application No. 69056 Permit No. 49989
IN NAME OF

INTERNATIONAL PAPER COMPANY

Surveyed Aug. 15, 1991., by B.S. JAMES...