

50109  
67771

TWP. 36 S, RANGE 10E, SECTION 26

Application No. 69130  
Permit No. 50109

WATER RESOURCES DEPT.  
SALEM, OREGON



BRASS SURVEY MARKER  
AT SECTION CORNER

22  
27 26

SCALE:  
12 INCHES = 1 MILE


CLIVE  
ELLIS  
6-9-87

**RECEIVED**

JUL 31 1987

WATER RESOURCES DEPT.  
SALEM, OREGON

SECTION CENTERLINE

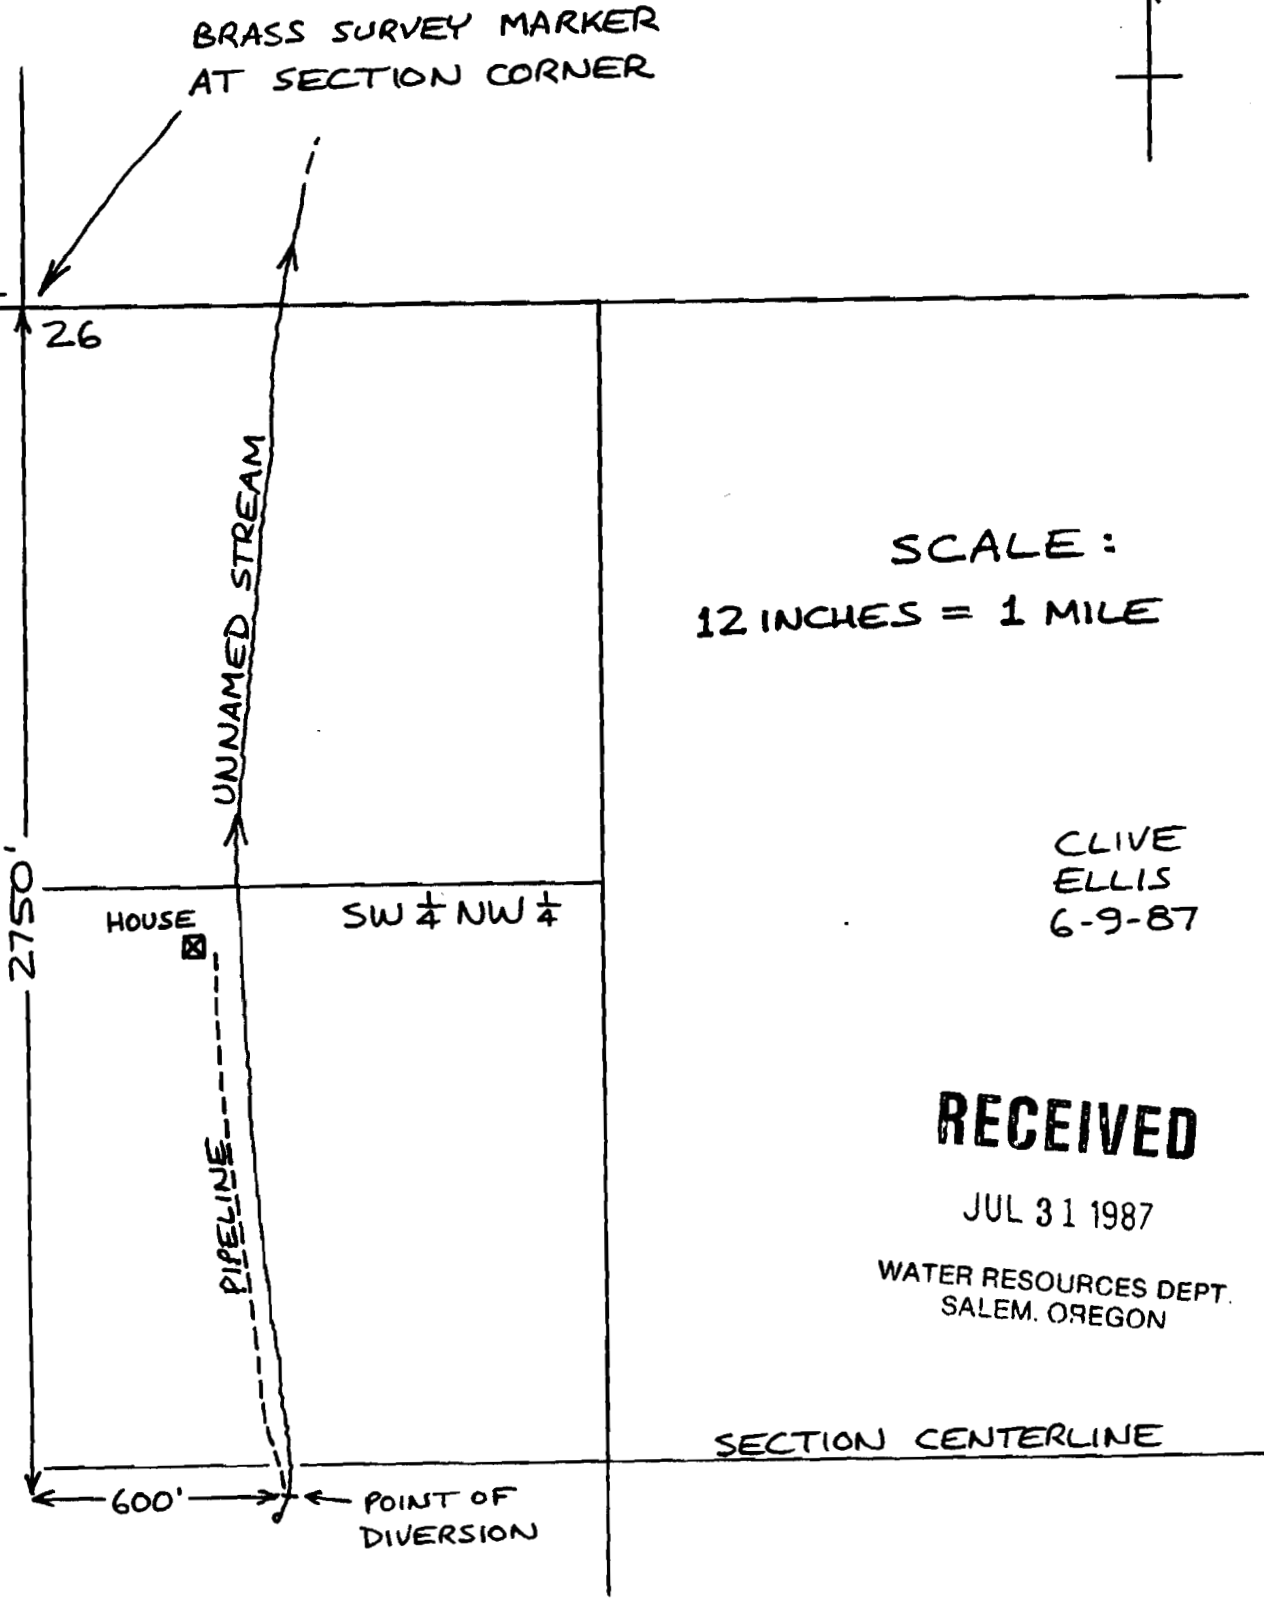

*Sprague Run Map*