


T. 23 S., R. 4 W., W.M.

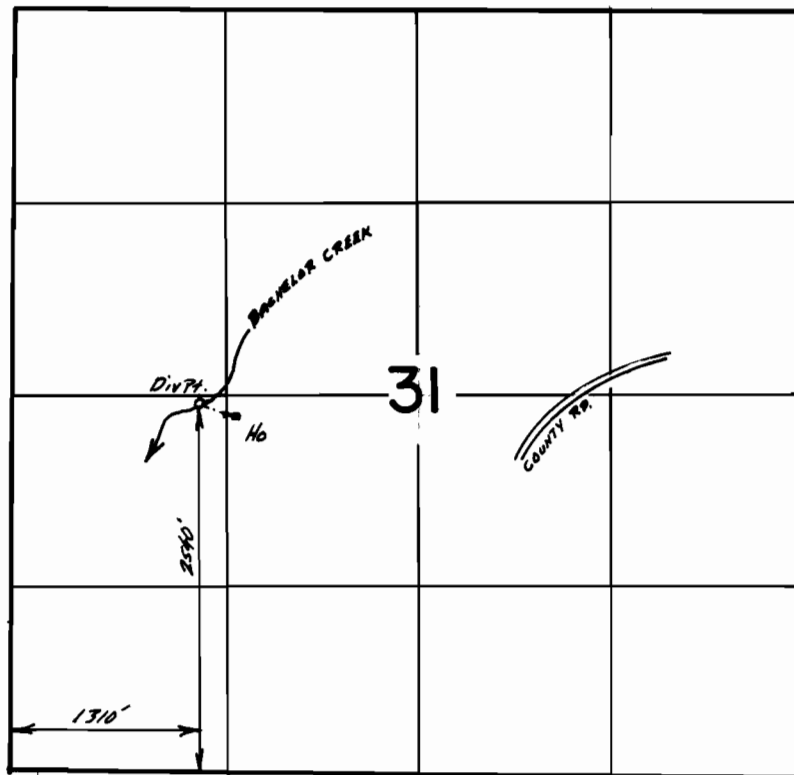

Scale 1" = 1320'

FINAL PROOF SURVEY
UNDER

Application No. 69171... Permit No. 50112.....
IN NAME OF

JUDITH ANN JEPSEN

Surveyed Sept. 10, 1991, by B.S. JAMES

235-46-51

Boj
4/92