



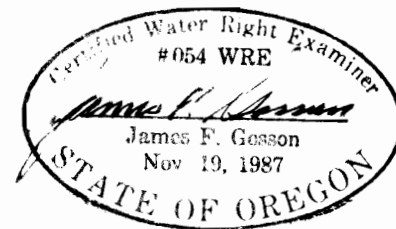

FINAL PROOF SURVEY MAP IN THE NAME OF RUBY McDUFFY COOK

SECTION 5, T23S, R4W, W.M.

1 INCH = 1320 FEET

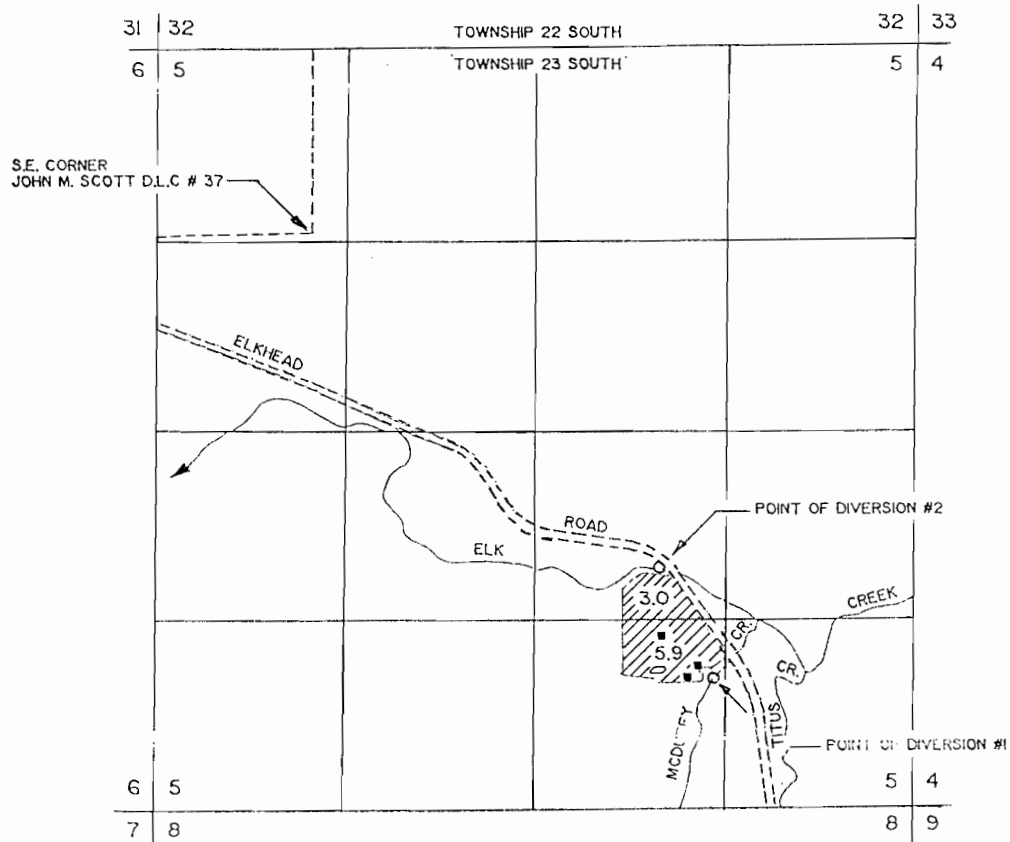

POINT OF DIVERSION #1 (McDUFFY CREEK) IS LOCATED 900 FEET NORTH AND 1380 FEET WEST FROM THE SOUTHEAST CORNER OF SECTION 5, BEING WITHIN THE SW 1/4 OF THE SE 1/4 OF SECTION 5.

POINT OF DIVERSION #2 (ELK CREEK) IS LOCATED 1650 FEET NORTH AND 1770 FEET WEST FROM THE SOUTHEAST CORNER OF SECTION 5, BEING WITHIN THE NW 1/4 OF THE SE 1/4 OF SECTION 5, BOTH BEING WITHIN TOWNSHIP 23 SOUTH, RANGE 4 WEST, W.M., DOUGLAS COUNTY.

THE PURPOSE OF THIS MAP IS TO IDENTIFY THE LOCATION OF THE WATER RIGHT. IT IS NOT INTENDED TO PROVIDE INFORMATION RELATIVE TO THE LOCATION OF PROPERTY OWNERSHIP BOUNDARY LINES.