


T. 24S., R. 34E., W.M.
HARNEY CO., ORE.

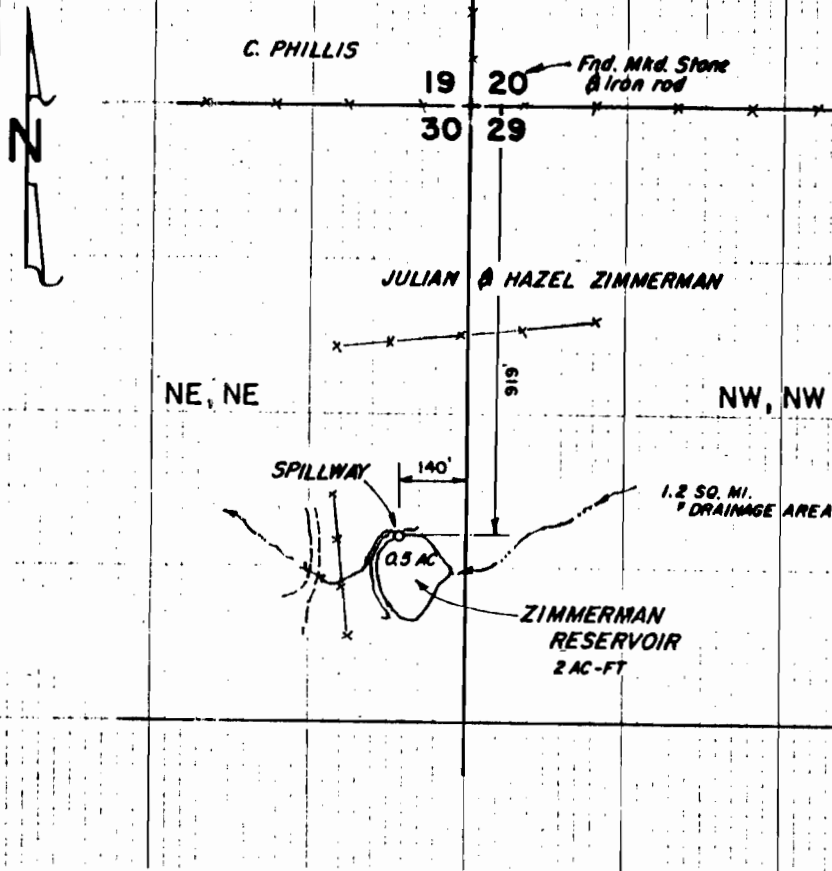

The purpose of this map is to identify a water right. It is not intended to provide information relative to the location of property ownership or boundary lines.

REVISED - 2/22/90 - TO CHANGE SCALE & ADD ABOVE NOTE - *C.F. Palmer*

JULIAN ZIMMERMAN

BURNS, OREGON

FINAL PROOF SURVEY
UNDER
PERMIT R-11008

Scale: 1" = 400'

Date: JULY 14, 1989

Job: 1181

Dsn: -

Drn: C.F.P.

Ckd: -

MAP's

M. A. Palmer & Sons
ENGINEERING & SURVEYING
254 N. Alder - Box 61
Burns, Oregon 97720

Sht. No.

of 1

