


T26S. R5W.WM

SCALE 1" = 1320'

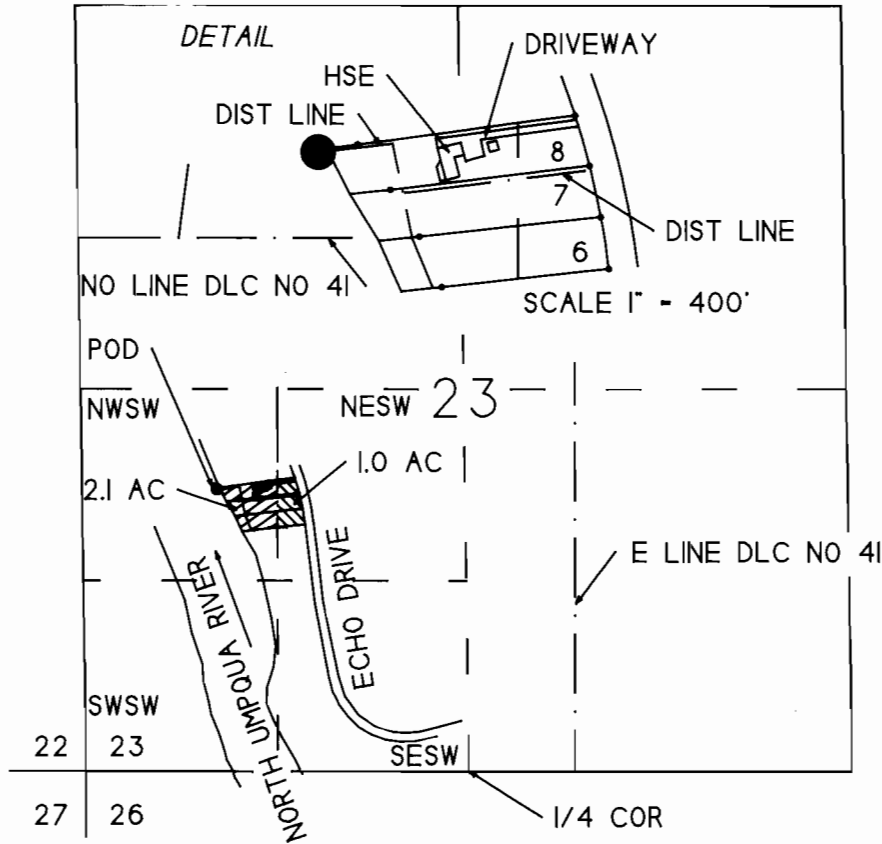

POD IS 1719 FT W AND 1950 FT N FROM S 1/4 COR SEC 23

## FINAL PROOF SURVEY

UNDER

Application No. 69866 Permit No. 50700

IN NAME OF

BRUCE H. OBERST, SR.

Surveyed July 16, 1991 by M E Farr



5-92