


- denotes cabin
- denotes cistern
- denotes spring

K CRUMBEIN ENGINEERING LTD. ENGINEERS - SURVEYORS - PLANNERS 361 S.E. Second Pendleton, Oregon	Scale 1" = 400'	Drn. By MLD	Drng. No. 89-08A	Revision 1 10-31-90
	Date 6-25-90	Ckd. By DHK	Job No. 8810	Revision 2 9-13-91

Final Proof for
A. MILES
LODMELL

Application No. 69966
Permit No. 50939
NW 1/4, Sec. 21, T6N, R38E, W.M.

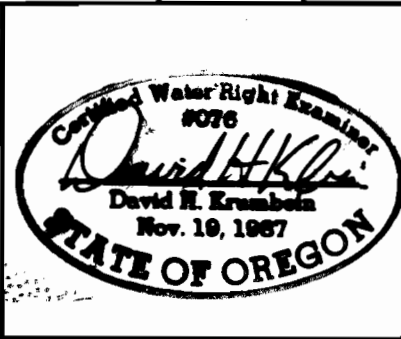

For Water Right
Purposes Only