


10342



TWP 26 S. R. 13 W. W.M

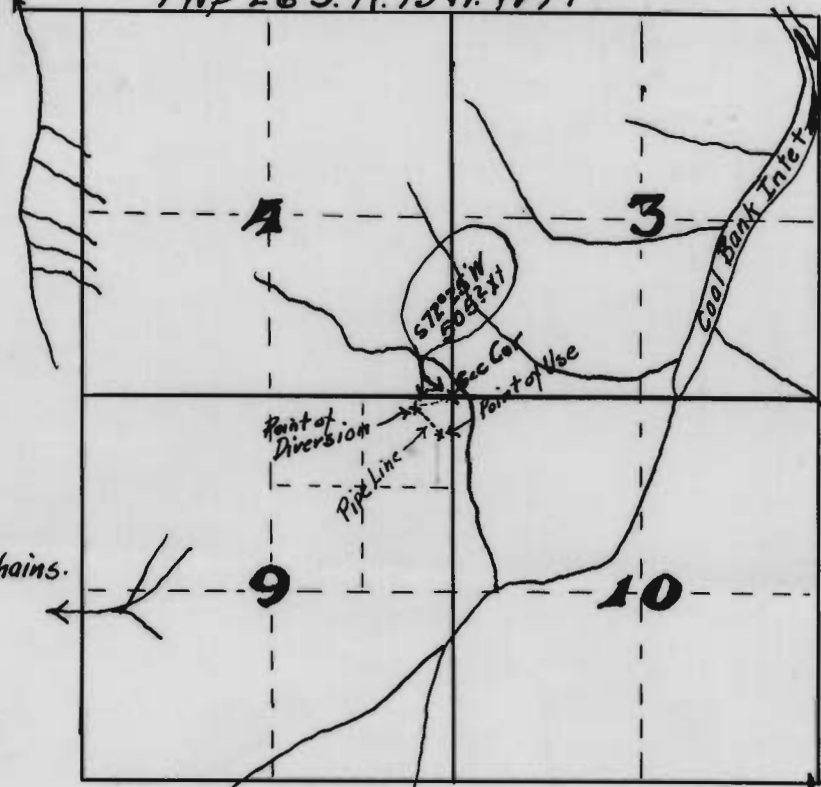

Scale
one inch = 40 chains.

MAP
To Accompany Application
of JOSEPH VAY
for a permit to appropriate
water for Domestic Use.
Section 9
Twp 26 S. R. 13 W.
Coos Co. Ore.

STATE ENGINEER
RECEIVED

AUG 17 1925

SALEM, OREGON



Application No. 10342

Permit No. 6937 I, D.L. Buckingham of Marshfield, Oregon, hereby

certify that this map was made from notes taken
during an actual survey made under my direction
July 28 1924 and that it correctly represents the
works described in the accompanying application
together with the location of the streams in the
immediate vicinity

D.L. Buckingham

10342

h
t
m
11