


T. 40 S., R. 8 W., W. M.

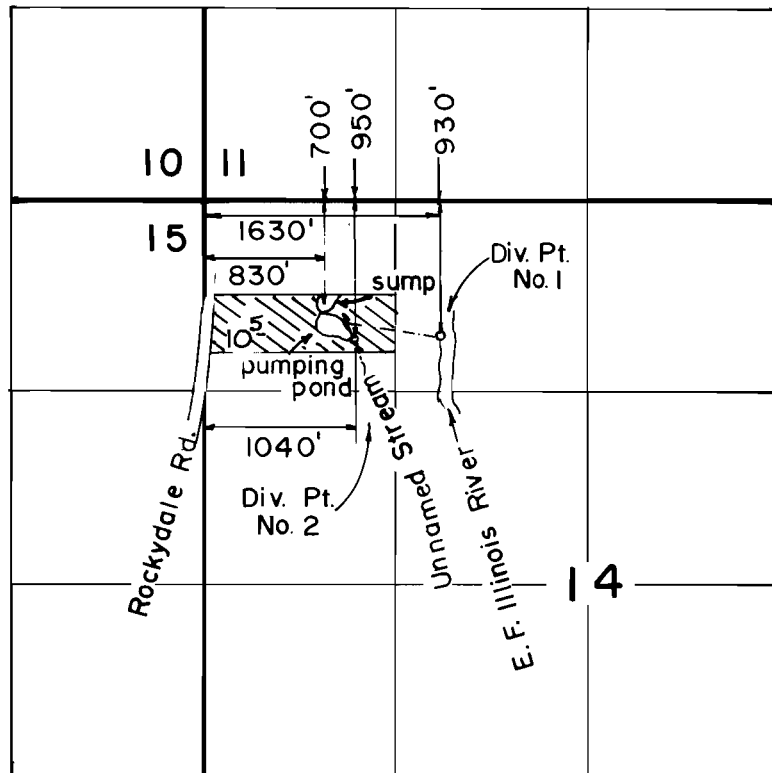

Scale: 1" = 1320'

FINAL PROOF SURVEY

UNDER

G-9830 G-9080
Application No. **60341** Permit No. **45180...**
IN NAME OF

LOTTE KERIVAN

Surveyed **APR. 17, 1986**, by **B. S. JAMES**