


T.38S., R.11E., W.M.

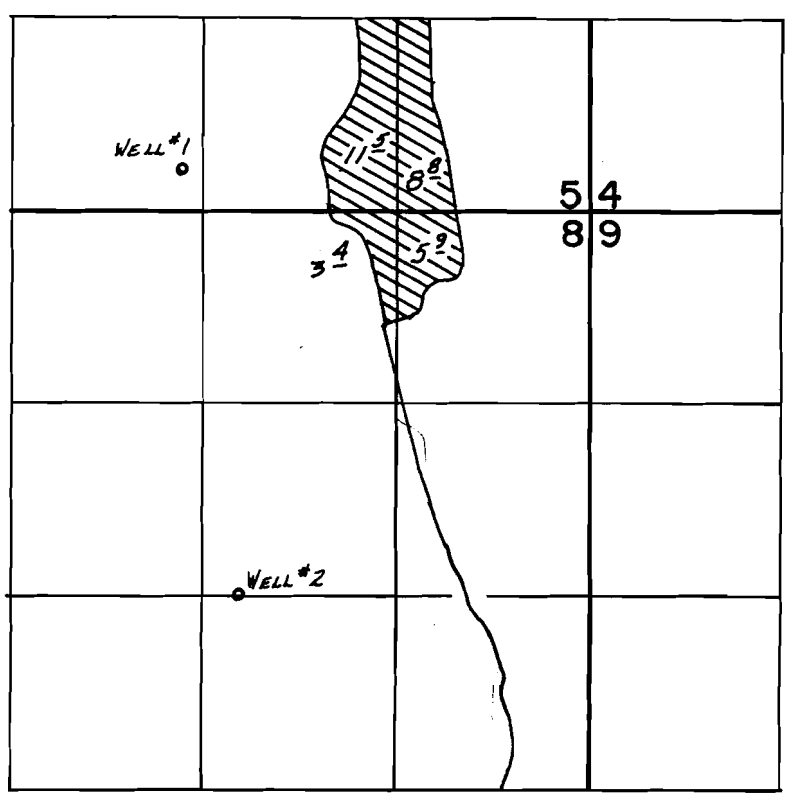

WELLS LOC.: #1-290'N. & 2790'W.; #2-2630'S. & 2410'W;
BOTH FROM NE COR. SEC. 8.

SCALE: 1" = 1320'

FINAL PROOF SURVEY

UNDER

Application No. G-10272 Permit No. G-9297.....
IN NAME OF

WALTER N. RITTER (RITTER RANCH, INC)

Surveyed Sept. 17, 1991, by B.W. BISHOP...

Buck Creek & Hanna Valley Wells