


N
↑

T.10 S. R.41 E. W.M.

SECTION 7
SW 1/4 NW 1/4

SCALE 1"=400'

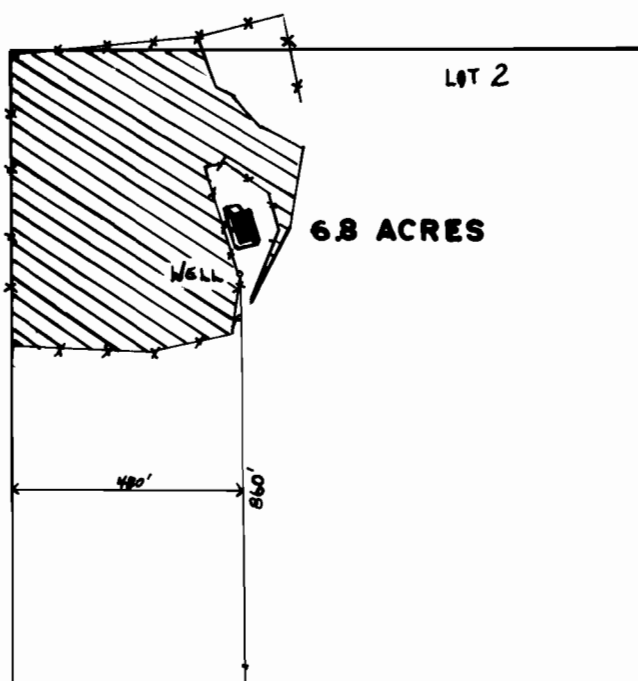

FINAL PROOF SURVEY
UNDER

Application No. **G-10502** Permit No. **G 9670**
IN NAME OF

JAMES E. SANDERS SR.

Surveyed **7-8** 1991, by **J. MILLER**