


T. 38 S., R. 3 W., W. M.

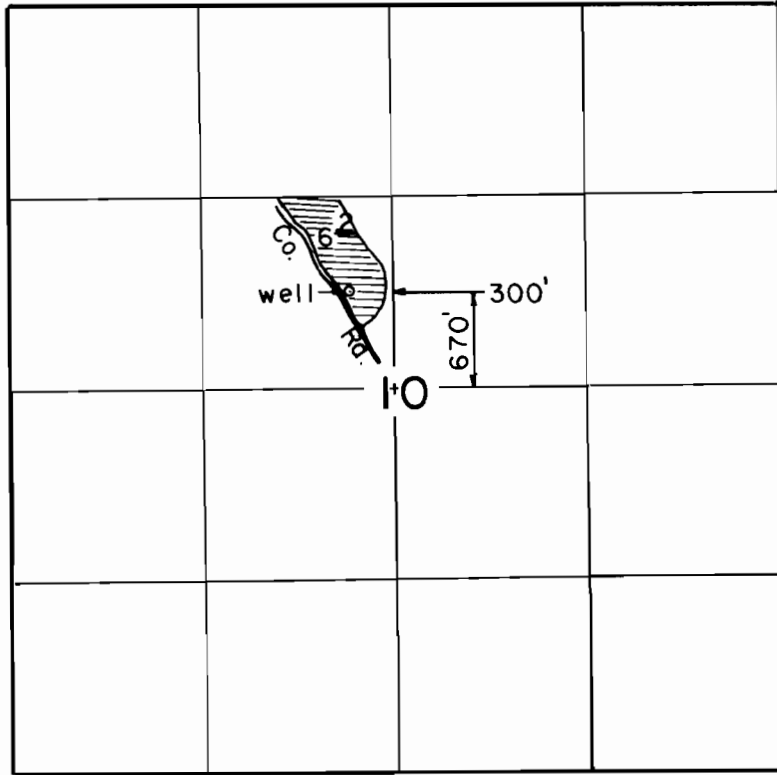

Scale: 1" = 1320'

FINAL PROOF SURVEY
UNDER

Application No. G-10621 Permit No. G-9901
IN NAME OF

.....L.E.E.....RICKORDS.....

Surveyed OCT. 24. 1991., by L.M. JOACHIMS