


T.36S.,R.12E.,W.M.

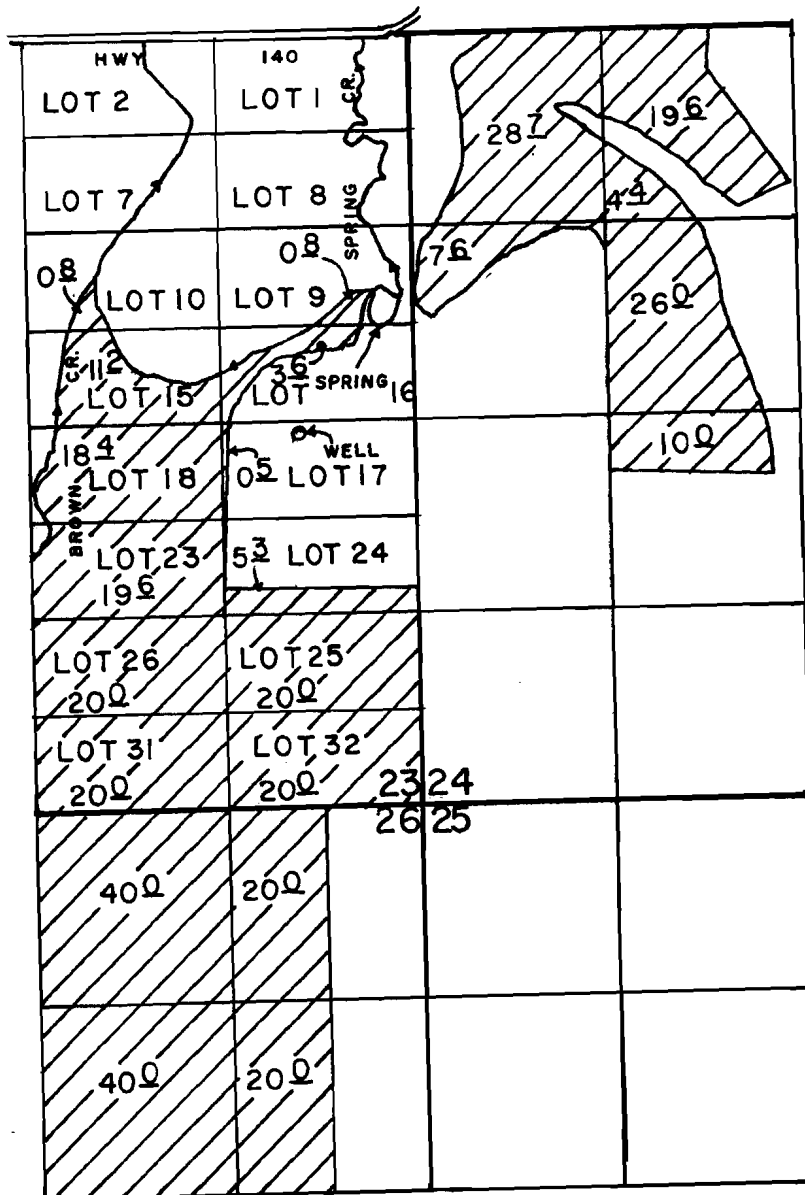

WELL LOC.: 2550' N. & 800' W. FROM SE COR. OF SEC 23.

SCALE: 1" = 1320'

FINAL PROOF SURVEY UNDER

Application No. G-11397. Permit No. G-10517....
IN NAME OF

FERRIS M. STOTLER AND EDWARD D. LANDELS

Surveyed NOV 29, 1991, by D. SPARKS