


T. 39 S., R. 8 & 9 E., W.M.

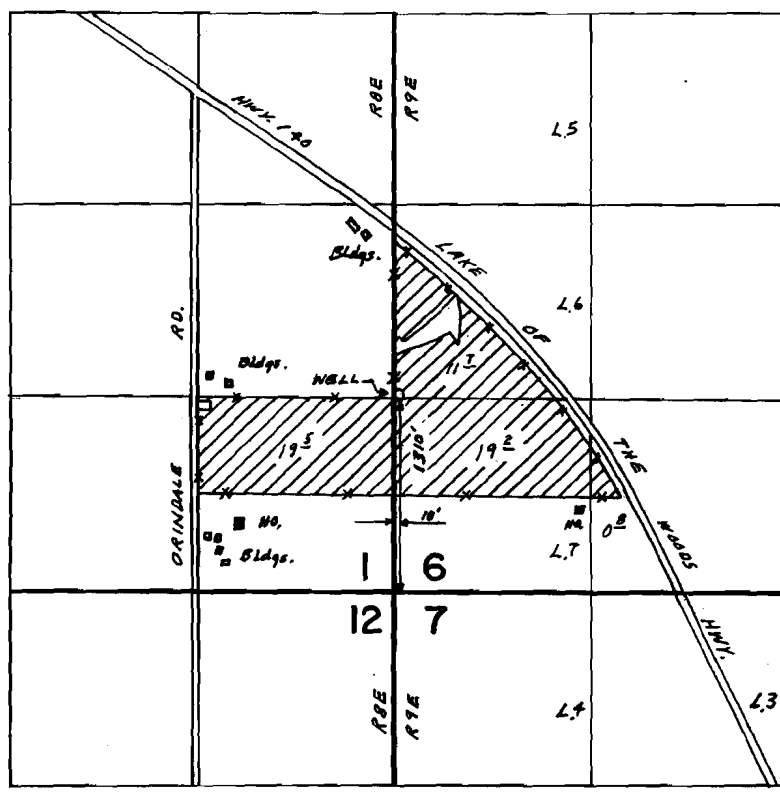

SCALE: 1"=1320'

FINAL PROOF SURVEY UNDER

Application No. G-11516. Permit No. G-10604...
IN NAME OF

JERRY & PATRICIA SCHUMANN...

Surveyed AUG. 20 1987, by B.S. JAMES.....

N. Av. Wells

3-7-89

L.A.C.