


G-10781

67862


T. 2N., R. 21 E., W.M.

Gilliam County N. E. Corner Section 15

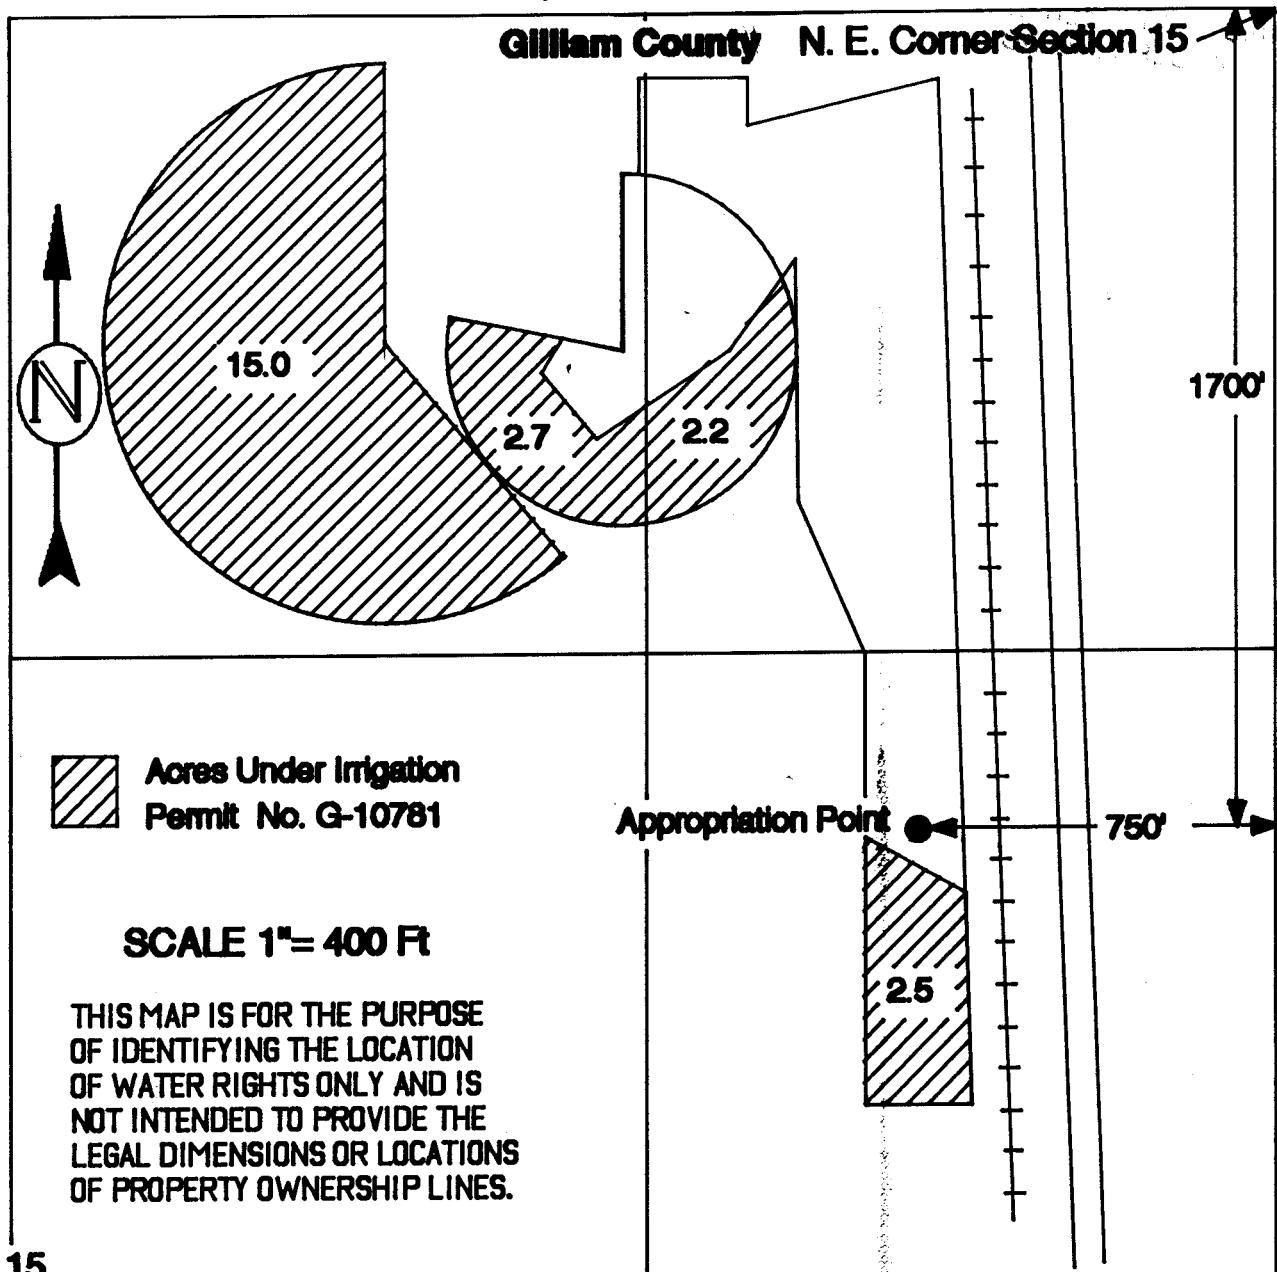

Well Located 1700 Ft South & 750 Ft West of the Northeast Corner of Sec. 15
SE 1/4 of NE 1/4 of Section 15, Township 2 North, Range 21 East W.M.

FINAL PROOF MAP
In Name of
Howard S. & Verna G. Stone

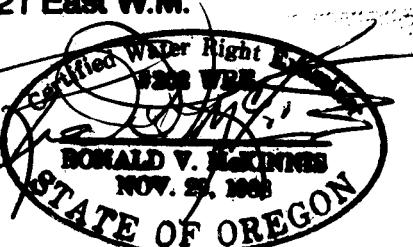

ENGINEERING - SURVEYING - WATER RIGHTS
R V MCKINNIS ENGINEERING
Rt 1 Box 1122 Hermiston, Oregon 97838
503-567-2017