



SOUTHEAST QUARTER, SECTION 9

67804

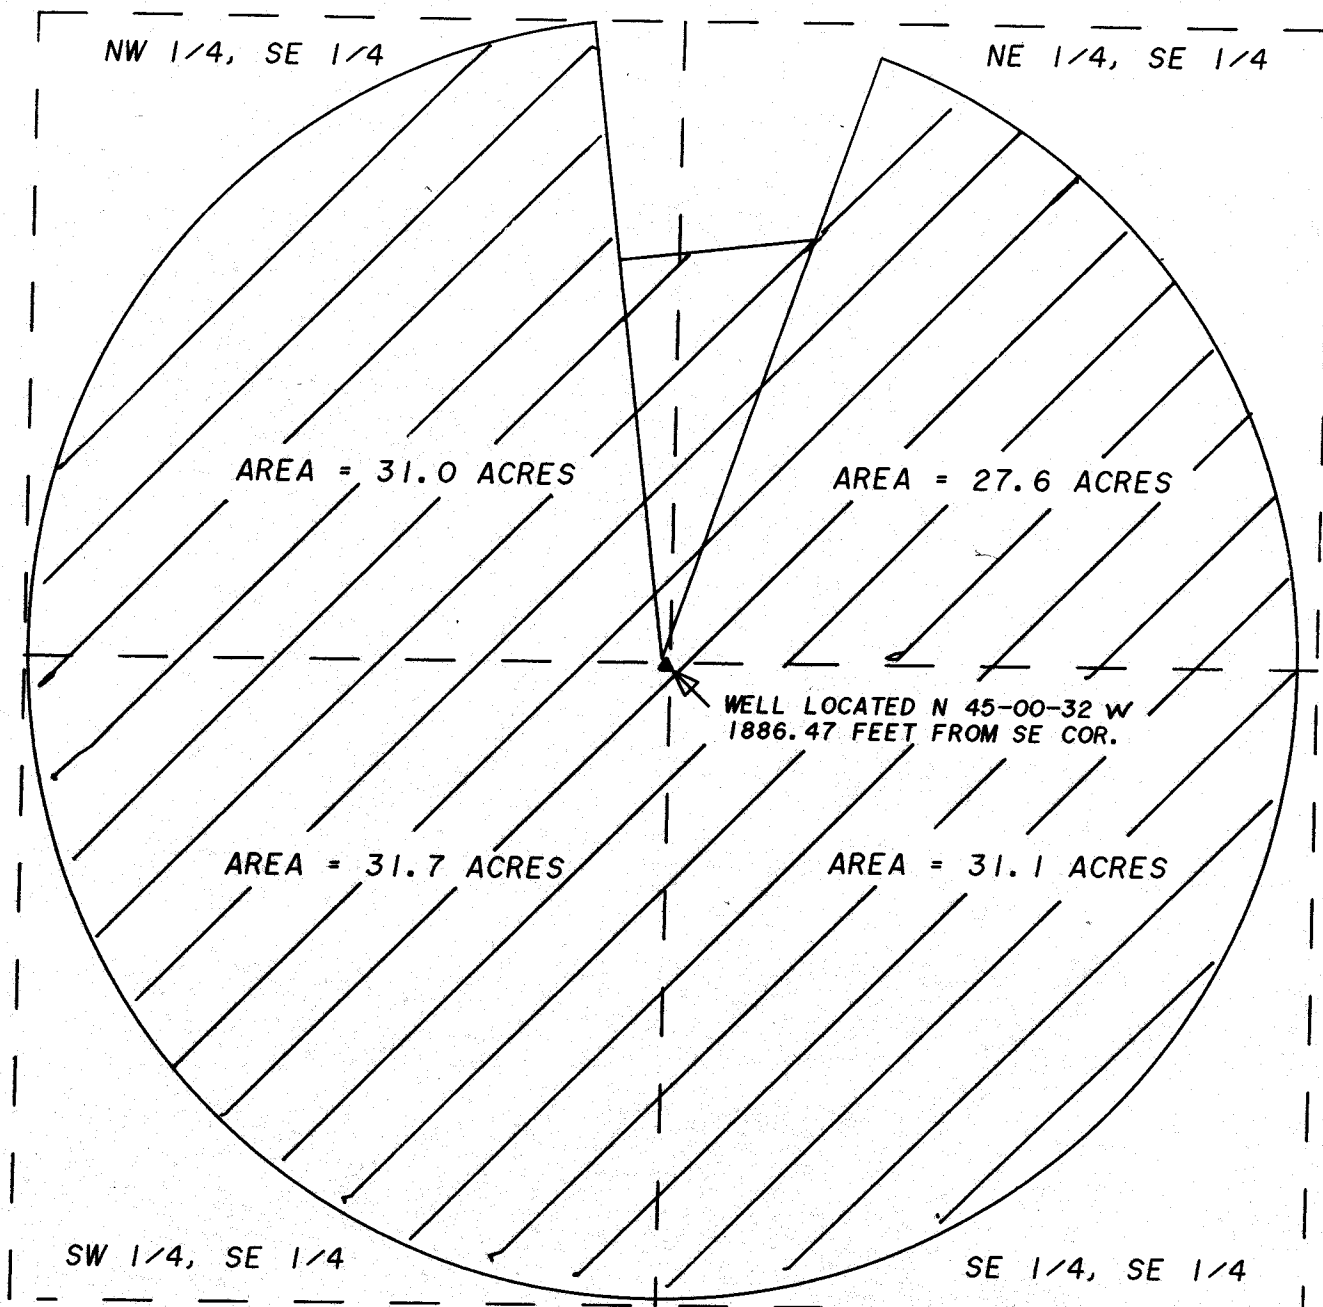

THIS DRAWING IS FOR WATER RIGHT PURPOSES ONLY, IT IS NOT INTENDED TO SHOW LAND SURVEY INFORMATION.

 KRUMBEIN ENGINEERING LTD. ENGINEERS - SURVEYORS - PLANNERS 361 S.E. Second Pendleton, Oregon	Scale 1" = 400'	Drn. By DHK	Drng. No. 9108A	Revision 1
	Date 11-16-91	Ckd. By	Job No. 9029	Revision 2
FINAL PROOF SURVEY BERKLEY F. DAVIS SE 1/4, SECTION 9 T 3 N., R. 34 E.W.M.	PERMIT #G10800 APPLICATION G-11783	