


T. 32 S., R. 15 W., W.M.

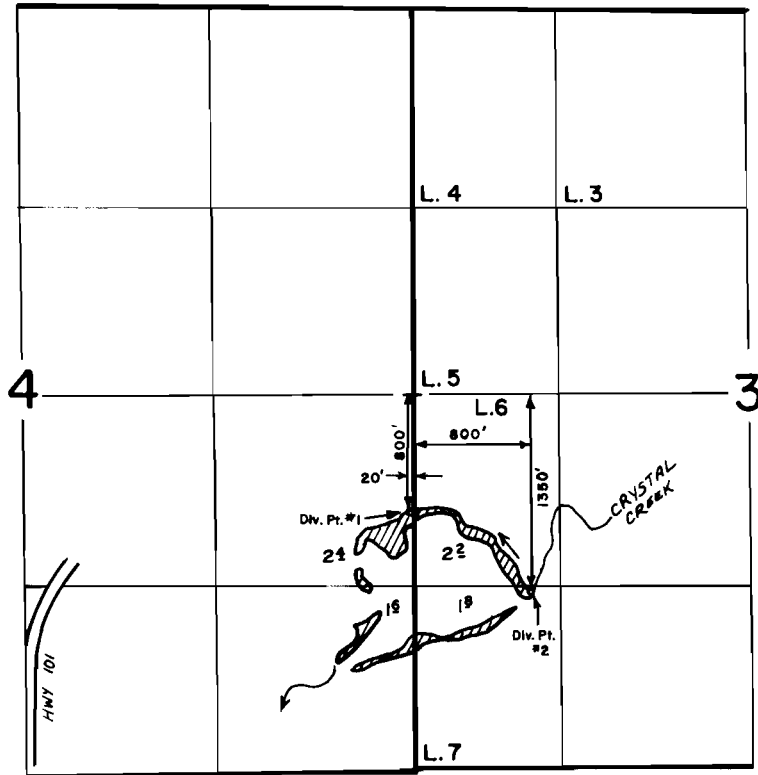

Scale 1" = 1320'

FINAL PROOF SURVEY
UNDER

Application No. 54731 Permit No. 41055
IN NAME OF

KELLY & JEAN PERKINS

June 5,

Surveyed June 26 1990, by B. S. JAMES