


T. 40 S., R. 13 W., W. M.

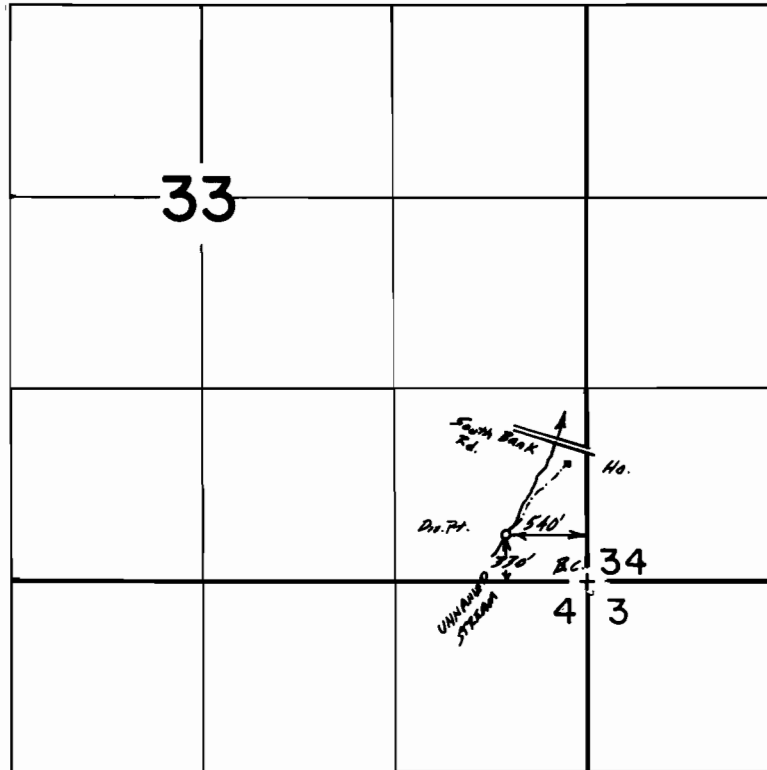

Scale : 1" = 1320'


**FINAL PROOF SURVEY**  
UNDER

Application No. 54789 Permit No. 41108.....  
IN NAME OF

EUGENE J. MARTIN.....

Surveyed July 19, 1978, by D. Sparks.....  
October 9, 1985, by J. M. Schmorde  
September 26, 1991 by B.S. James

T.40S. R.13W. W.M.

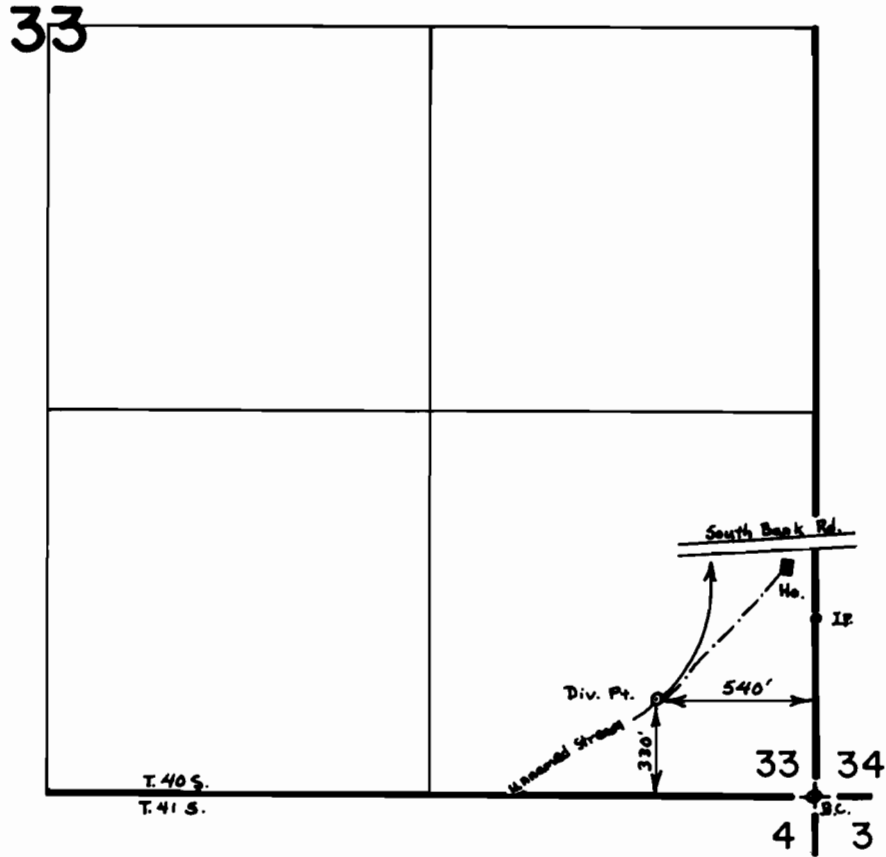

SCALE: 8" = 1 mile

**FINAL PROOF SURVEY  
UNDER**

Application No. 54789 Permit No. 41108  
IN NAME OF

EUGENE J. MARTIN

Surveyed July 19, 1978, by D. Sparks