


T. 33 S., R. 2 E., W. M.

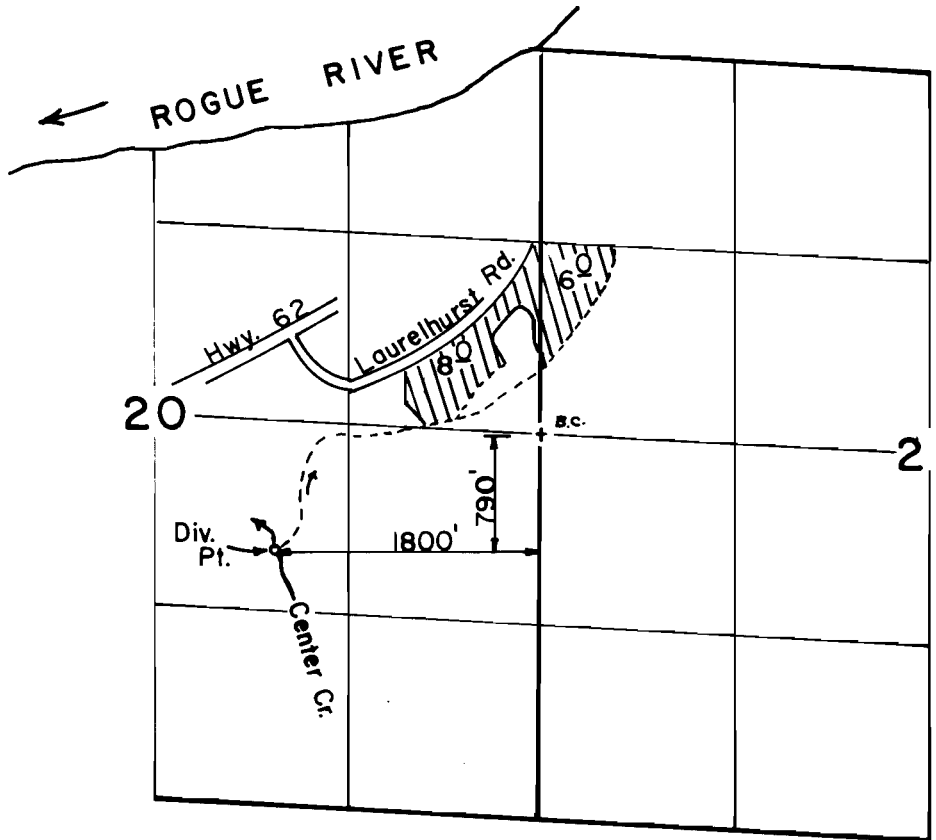

Scale: 1" = 1320'

FINAL PROOF SURVEY
UNDER

Application No. 55,110. Permit No. 4,388...
IN NAME OF

JANTZER...and...SONS...LOGGING

Surveyed JULY 2, 1991, by B. S. JAMES...