


T. 30S., R. 6W., W. M.

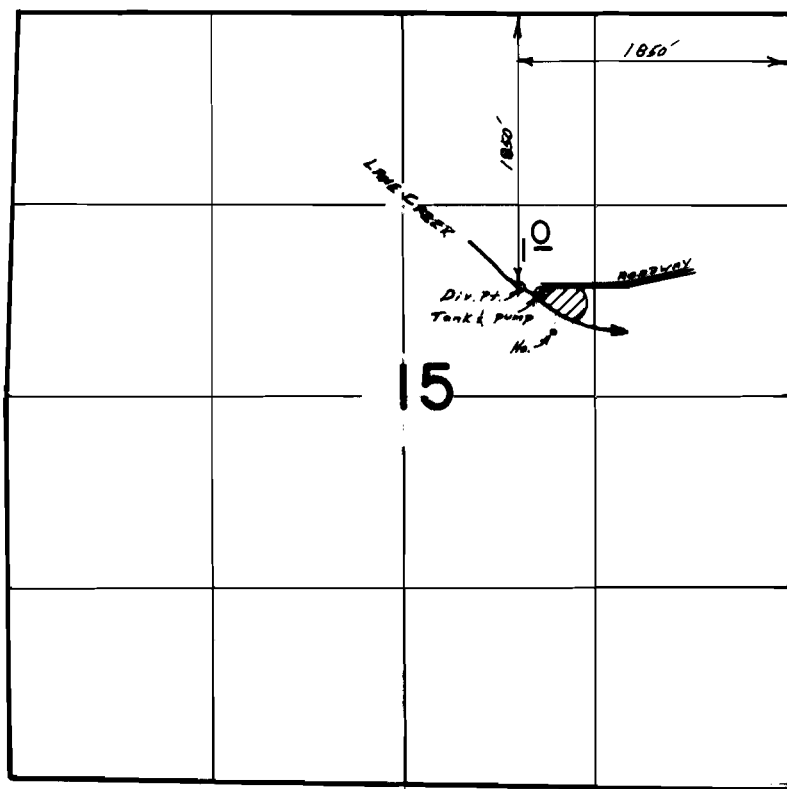

Scale 1"=1320'

**FINAL PROOF SURVEY
UNDER**

Application No. 56483 Permit No. 42072...
IN NAME OF

.....MARY K. O'HARE.....

Surveyed March 28, 1990, by BS. James.....