


T.9S., R.39E., W.M.

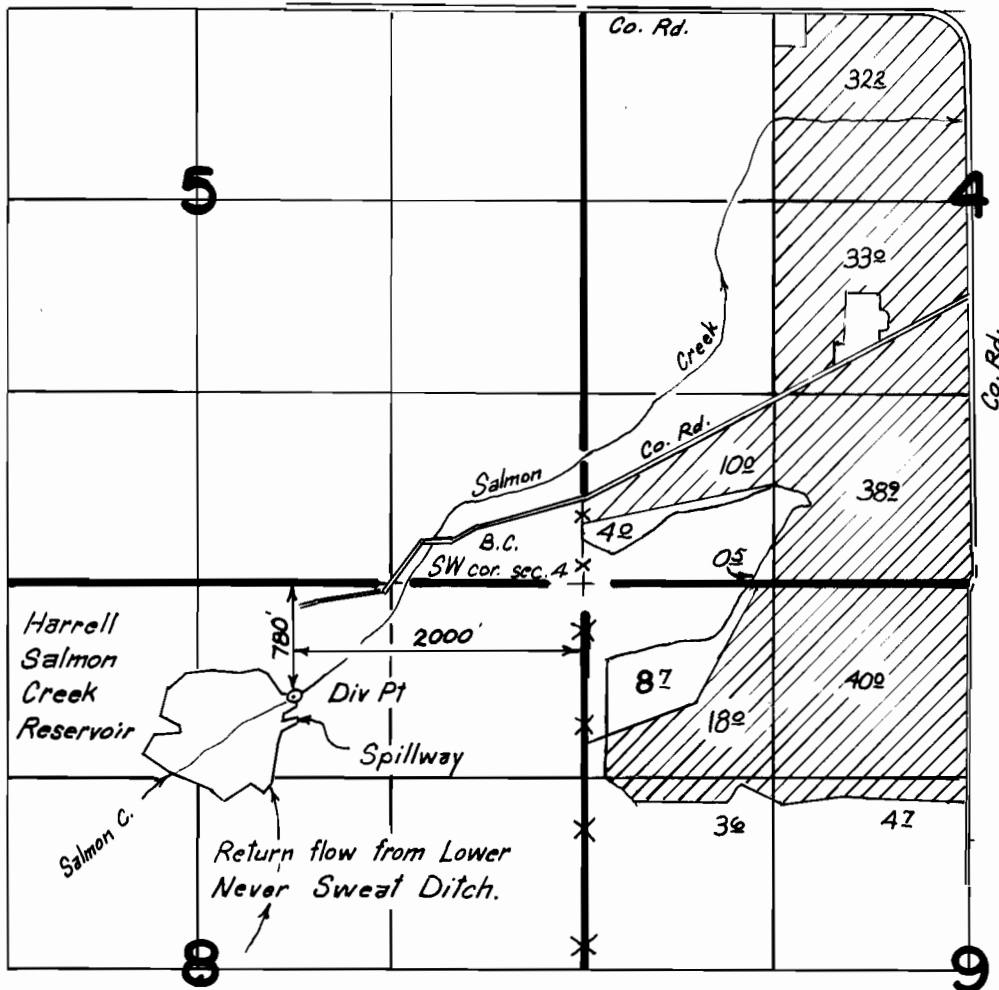

FINAL PROOF SURVEY UNDER

Scale: 1" = 1320'

R-56691 R-8346
Application No. 59380 Permit No. 46426
IN NAME OF

.....HARRELL HEREFORD RANCH.....

Surveyed 5-20 1987, by Vern Church.....

41001-279-90R

BBB-4KK-268

P.T.S. 1987 P.C.

KK 12-21-88