


T. 33 S., R. 2 E., W. M.

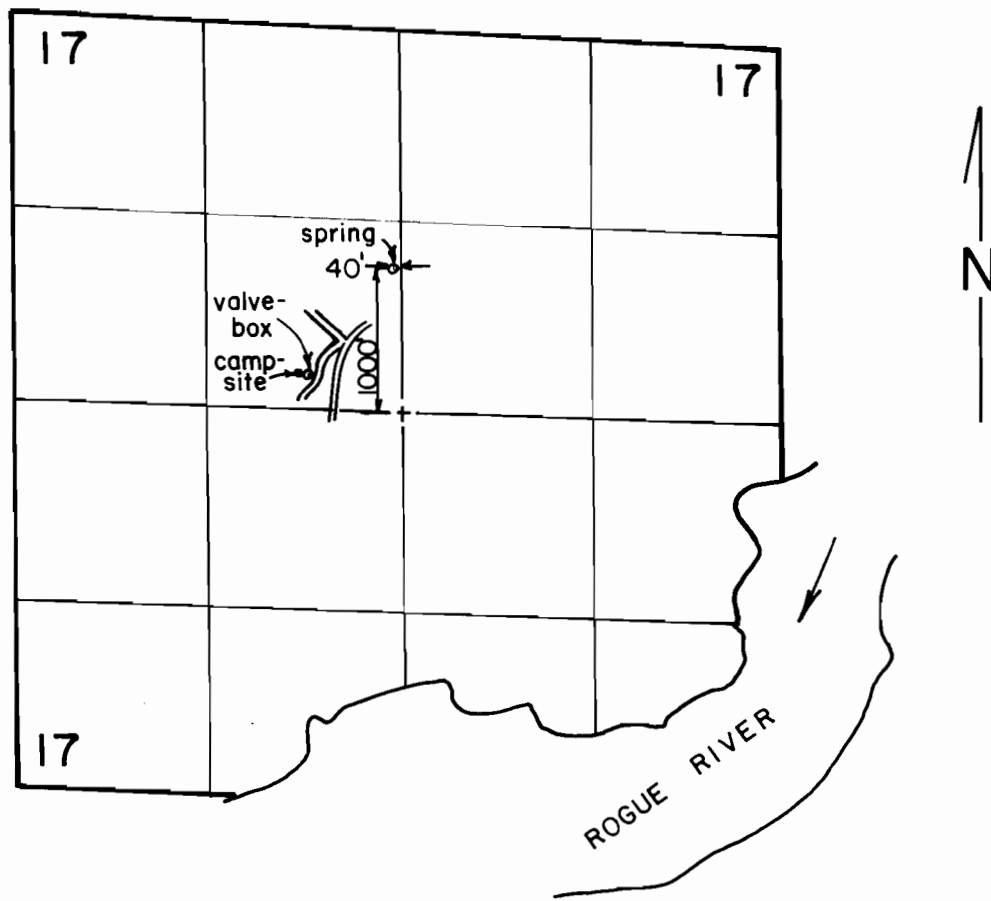

Scale: 1" = 1320'

FINAL PROOF SURVEY
UNDER

Application No. 57664 Permit No. 43428...
IN NAME OF

JOHN ..CLARENCE... & ..EUNICE...D....WRIGHT

Surveyed JULY..2.. 1991.., by B..S...JAMES...