


T. 35 S., R. 14 W., W. M.

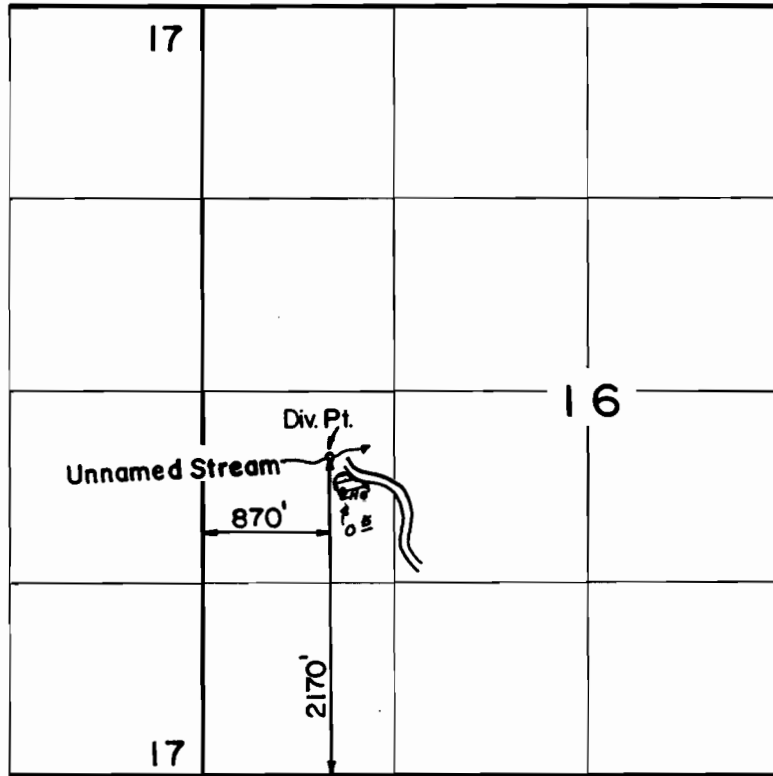

Scale: 1" = 1320'

FINAL PROOF SURVEY
UNDER

Application No. 57752 Permit No. 44021..
IN NAME OF

DONALD...N... & ...MARY...E...WADLEIGH

Surveyed JUN. 28 1988, by B. S. JAMES.