


T.9S., R.39E., W.M.

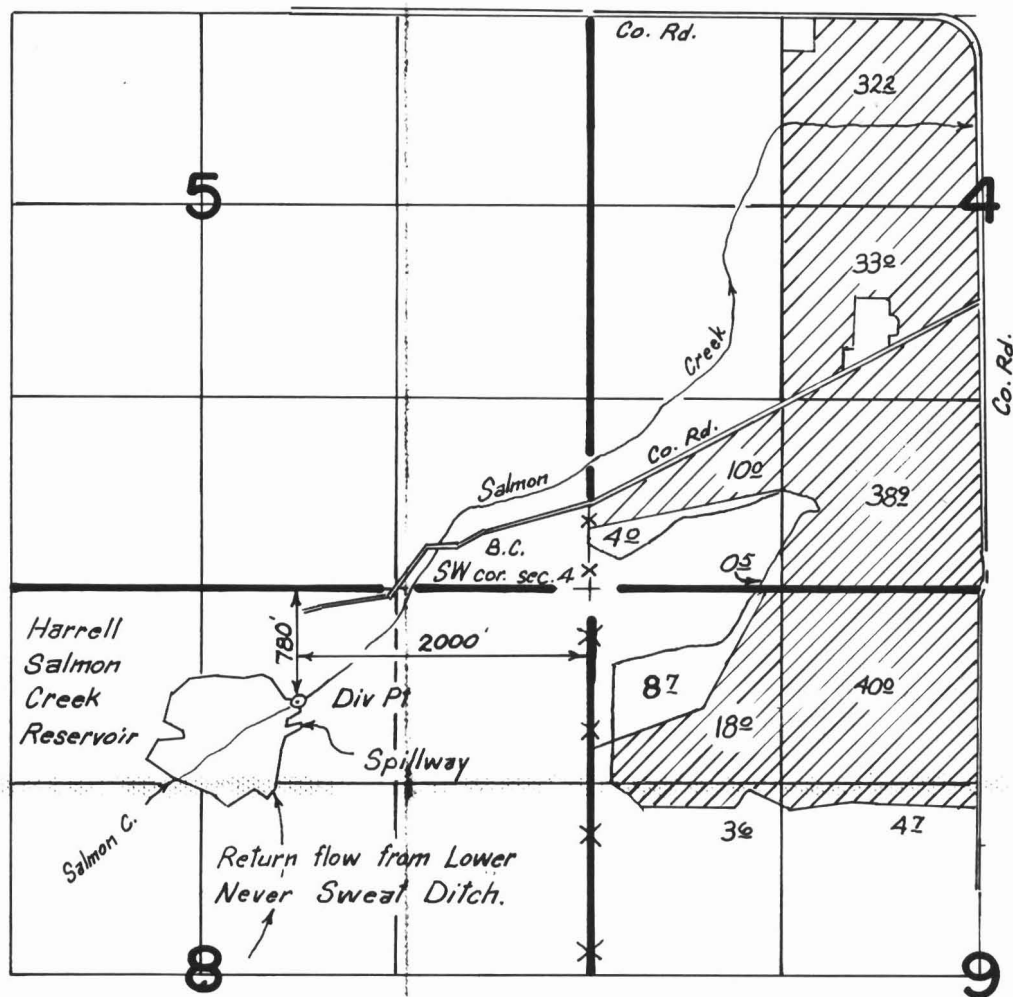

FINAL PROOF SURVEY
UNDER

Scale: 1" = 1320'

R-56691 R-8346
Application No. 59380 Permit No. 46426
IN NAME OF

HARRELL HEREFORD RANCH

Surveyed 5-20-1987, by Vern Church

41001-279-90R
BBB-4KK-268
P.T.S. 1987 P.C. KK 12-21-88