


T. 29S., R. 6 W., W. M.

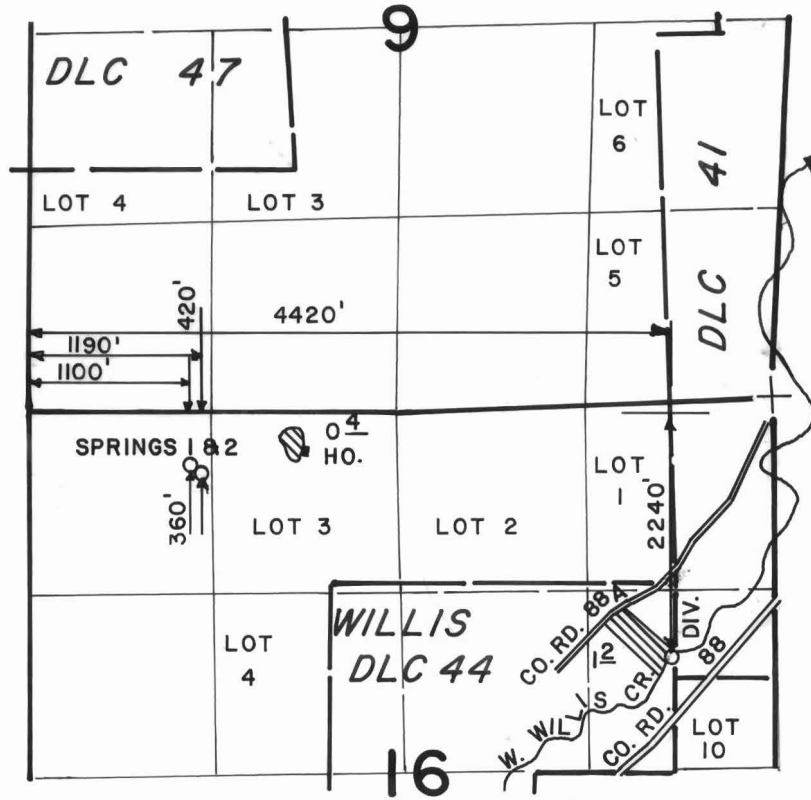

SCALE: 4" = 1 MILE

FINAL PROOF SURVEY UNDER

Application No. 60714... Permit No. 46533...
IN NAME OF

JACK T. NORTON, JR.

Surveyed JUNE 18, 1987, by J. M. SCHMORDE