


T. 33 S., R. 5 W., W. M.

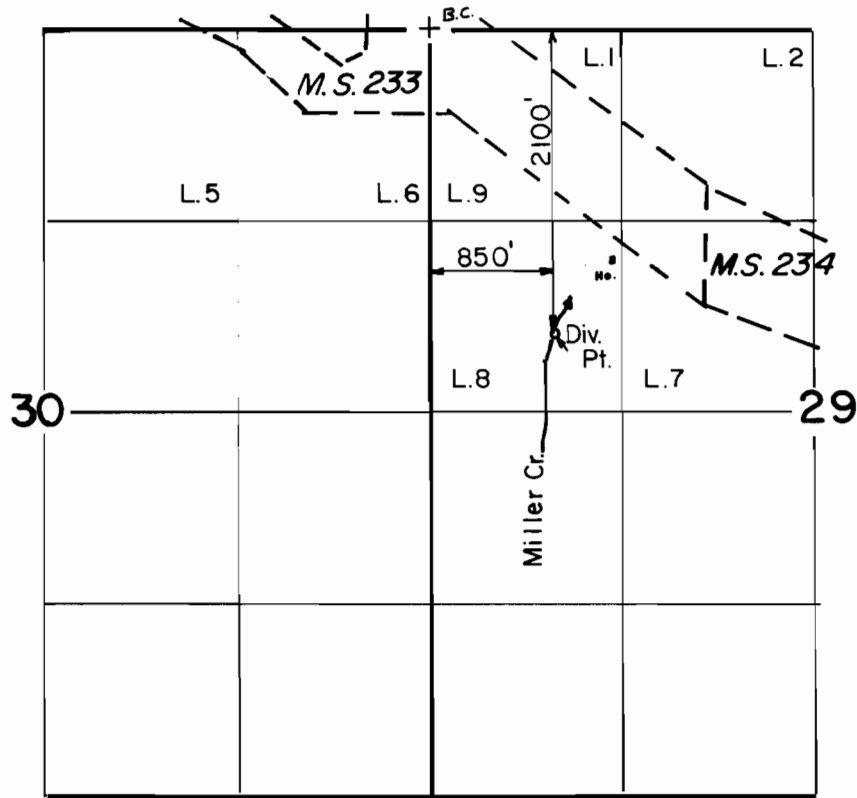

Scale: 1" = 1320'

FINAL PROOF SURVEY
UNDER

Application No. 60853 Permit No. 4.6555...
IN NAME OF

DOROTHEA.....JUNE....SPANGRUD

Surveyed MAY..4.. 1989, by R.S...JAMES...