


T. 24 S., R. 7 W., W. M.

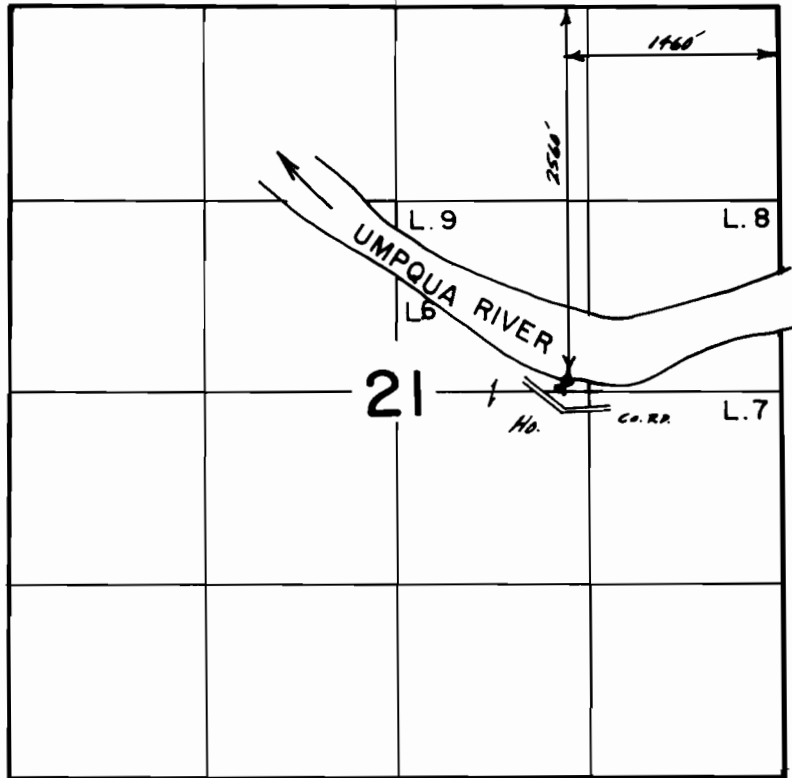

Scale 1" = 1320'

**FINAL PROOF SURVEY
UNDER**

Application No. 60855 Permit No. 45184.....
IN NAME OF

.....EDWIN.....CHARLES YEAMANS

Surveyed Oct. 1., 1991., by B.S. James.....