
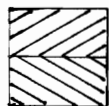


T.17S., R.25E., W.M.

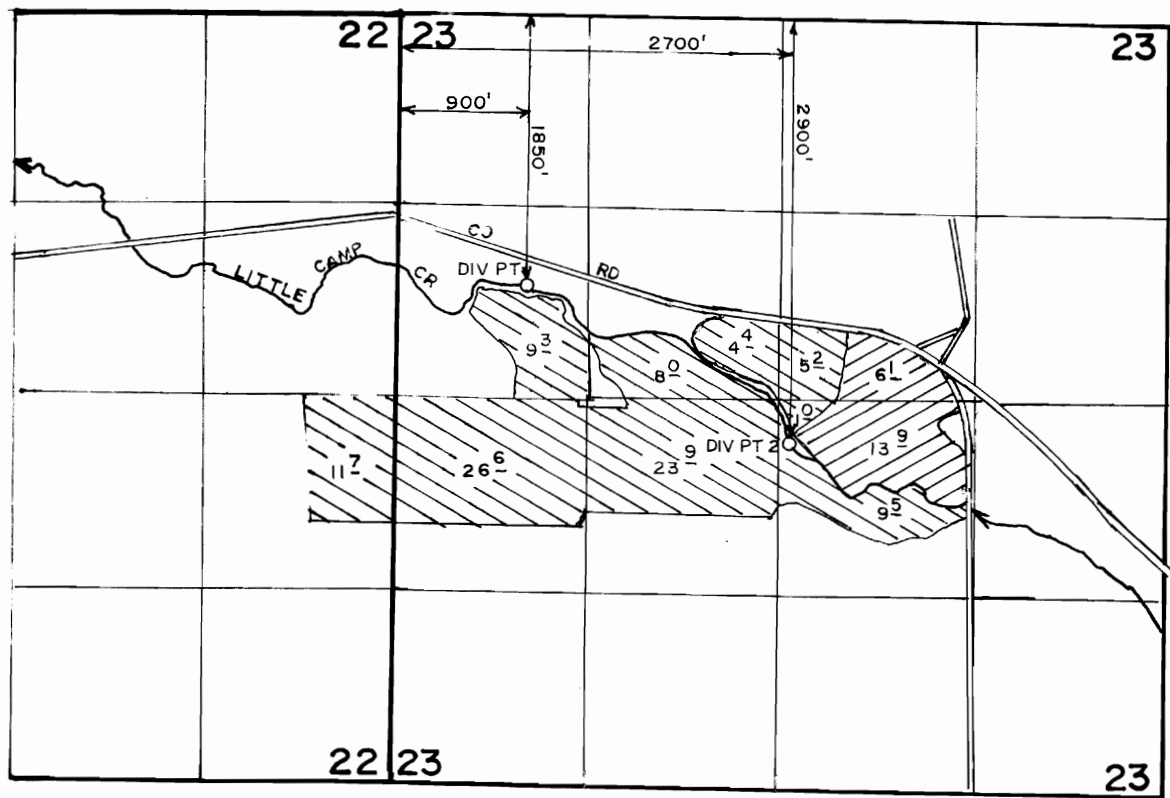

Transfer 4660

Permit 46205

SCALE: 1"=1320'

FINAL PROOF SURVEY UNDER

TRANSFER NO. 4660

Application No. 60982... Permit No. 46205.....
IN NAME OF

....ANDREW.....BERNARD...RANCH.....

Surveyed JAN. 18.. 1990., by B.W.BISHOP.....