


T. 24 S., R. 5 W., W. M.

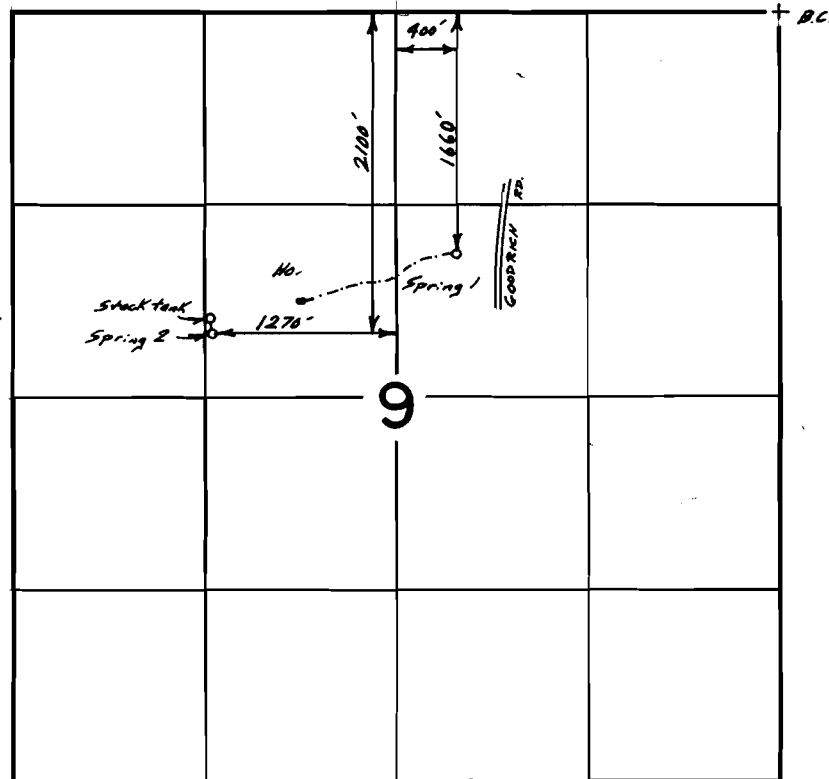

Scale 1" = 1320'



**FINAL PROOF SURVEY**  
UNDER

Application No. 61598 Permit No. 45964...  
IN NAME OF

.....RICHARD D. RAWSON.....

Surveyed Oct. 8, 1991, by B.S. James.....