


T. 33 S., R. 15 W., W.M.

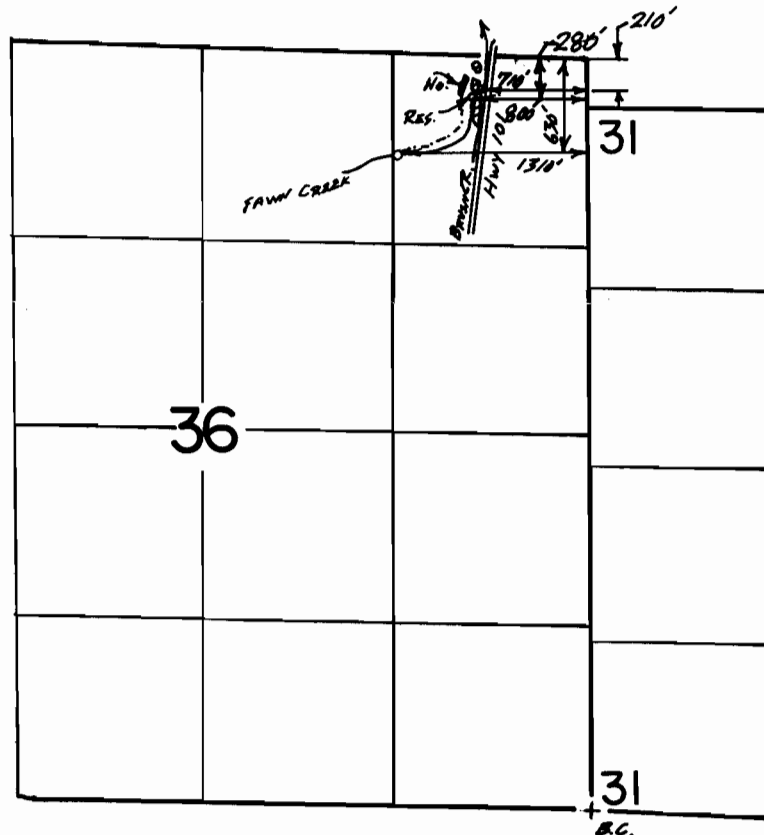

Scale 1" = 1320'

FINAL PROOF SURVEY
UNDER

R-64511 R-8666
Application No. 64512 Permit No. 47455
IN NAME OF

.....
Surveyed Sept. 24 1991, by B.S. James.....