


T. 30 S., R. 3 W., W. M.

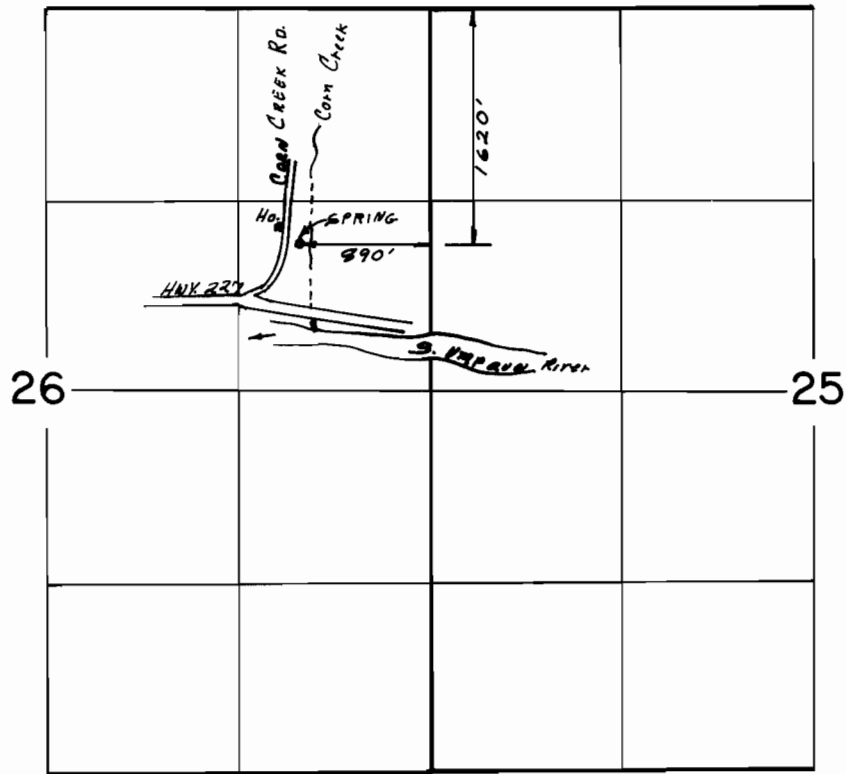

Scale: 1" = 1320'

**FINAL PROOF SURVEY
UNDER**

Application No. 64537 Permit No. 47288....
IN NAME OF

GEORGE J. and REBECCA A. RAMOS

Surveyed MAR. 27 1990., by R. S. JAMES....