


T. 27 & 28 S., R. 7 W., W.M.

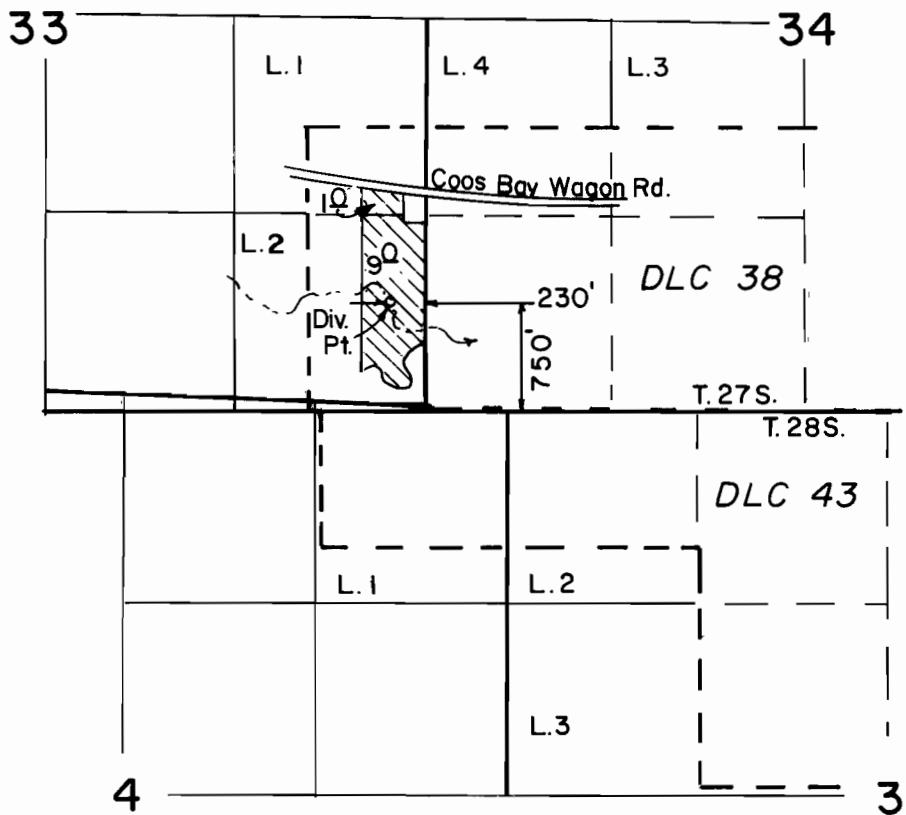

Scale: 1" = 1320'

**FINAL PROOF SURVEY**  
UNDER

Application No. 65268 Permit No. 47886...  
IN NAME OF

.....RISE, MERCIER-BRIGGS.....

Surveyed AUG. 30, 1990, by R. S. JAMES...