


T. 33 S., R. 5 & 6 W., W. M.

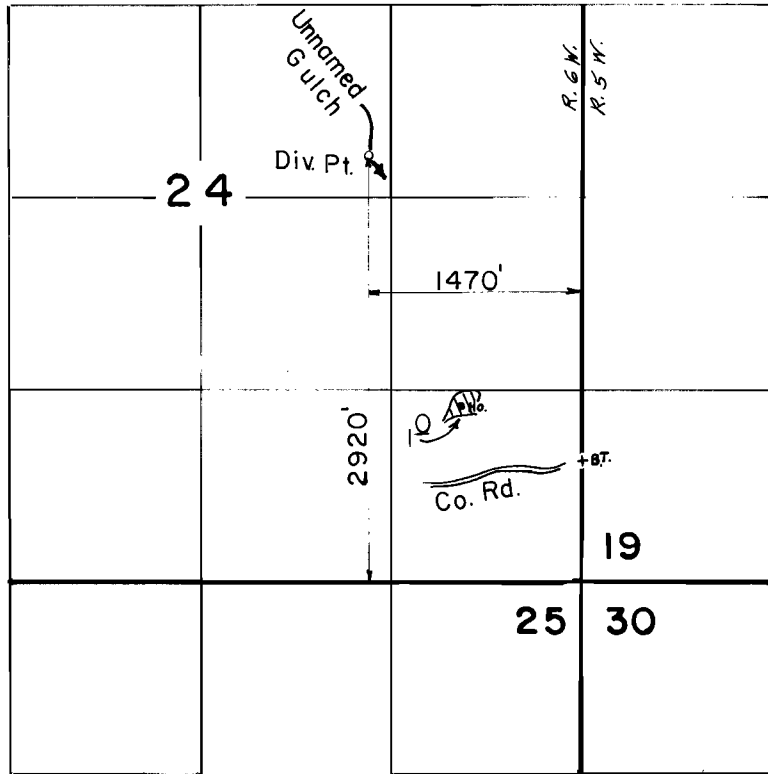

Scale: 1" = 1320'

**FINAL PROOF SURVEY**  
UNDER

Application No. ~~65479~~ Permit No. ~~47961~~....  
IN NAME OF

JERRY.....L.....KILLINGSWORTH..

Surveyed MAY...3. 1989, by B...S...JAMES.