


T. 32 S., R. 7 W., W.M.

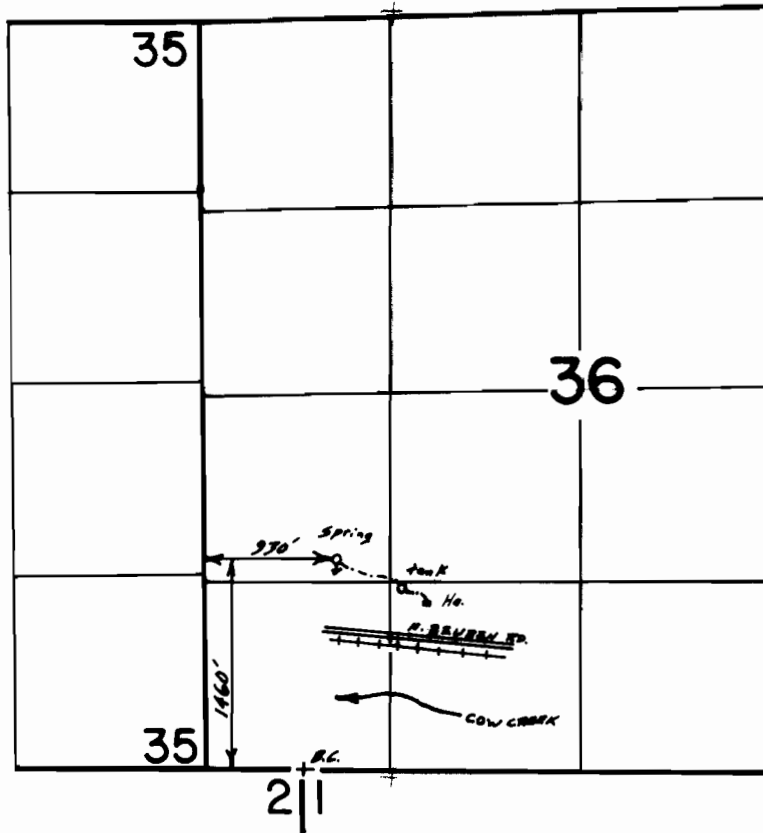

Scale 1"=1320'

**FINAL PROOF SURVEY
UNDER**

Application No. ~~66666~~ Permit No. 48102....
IN NAME OF

.....JEROME BRIAN PETERSON.....

Surveyed July 11, 1990, by B.S. James.....