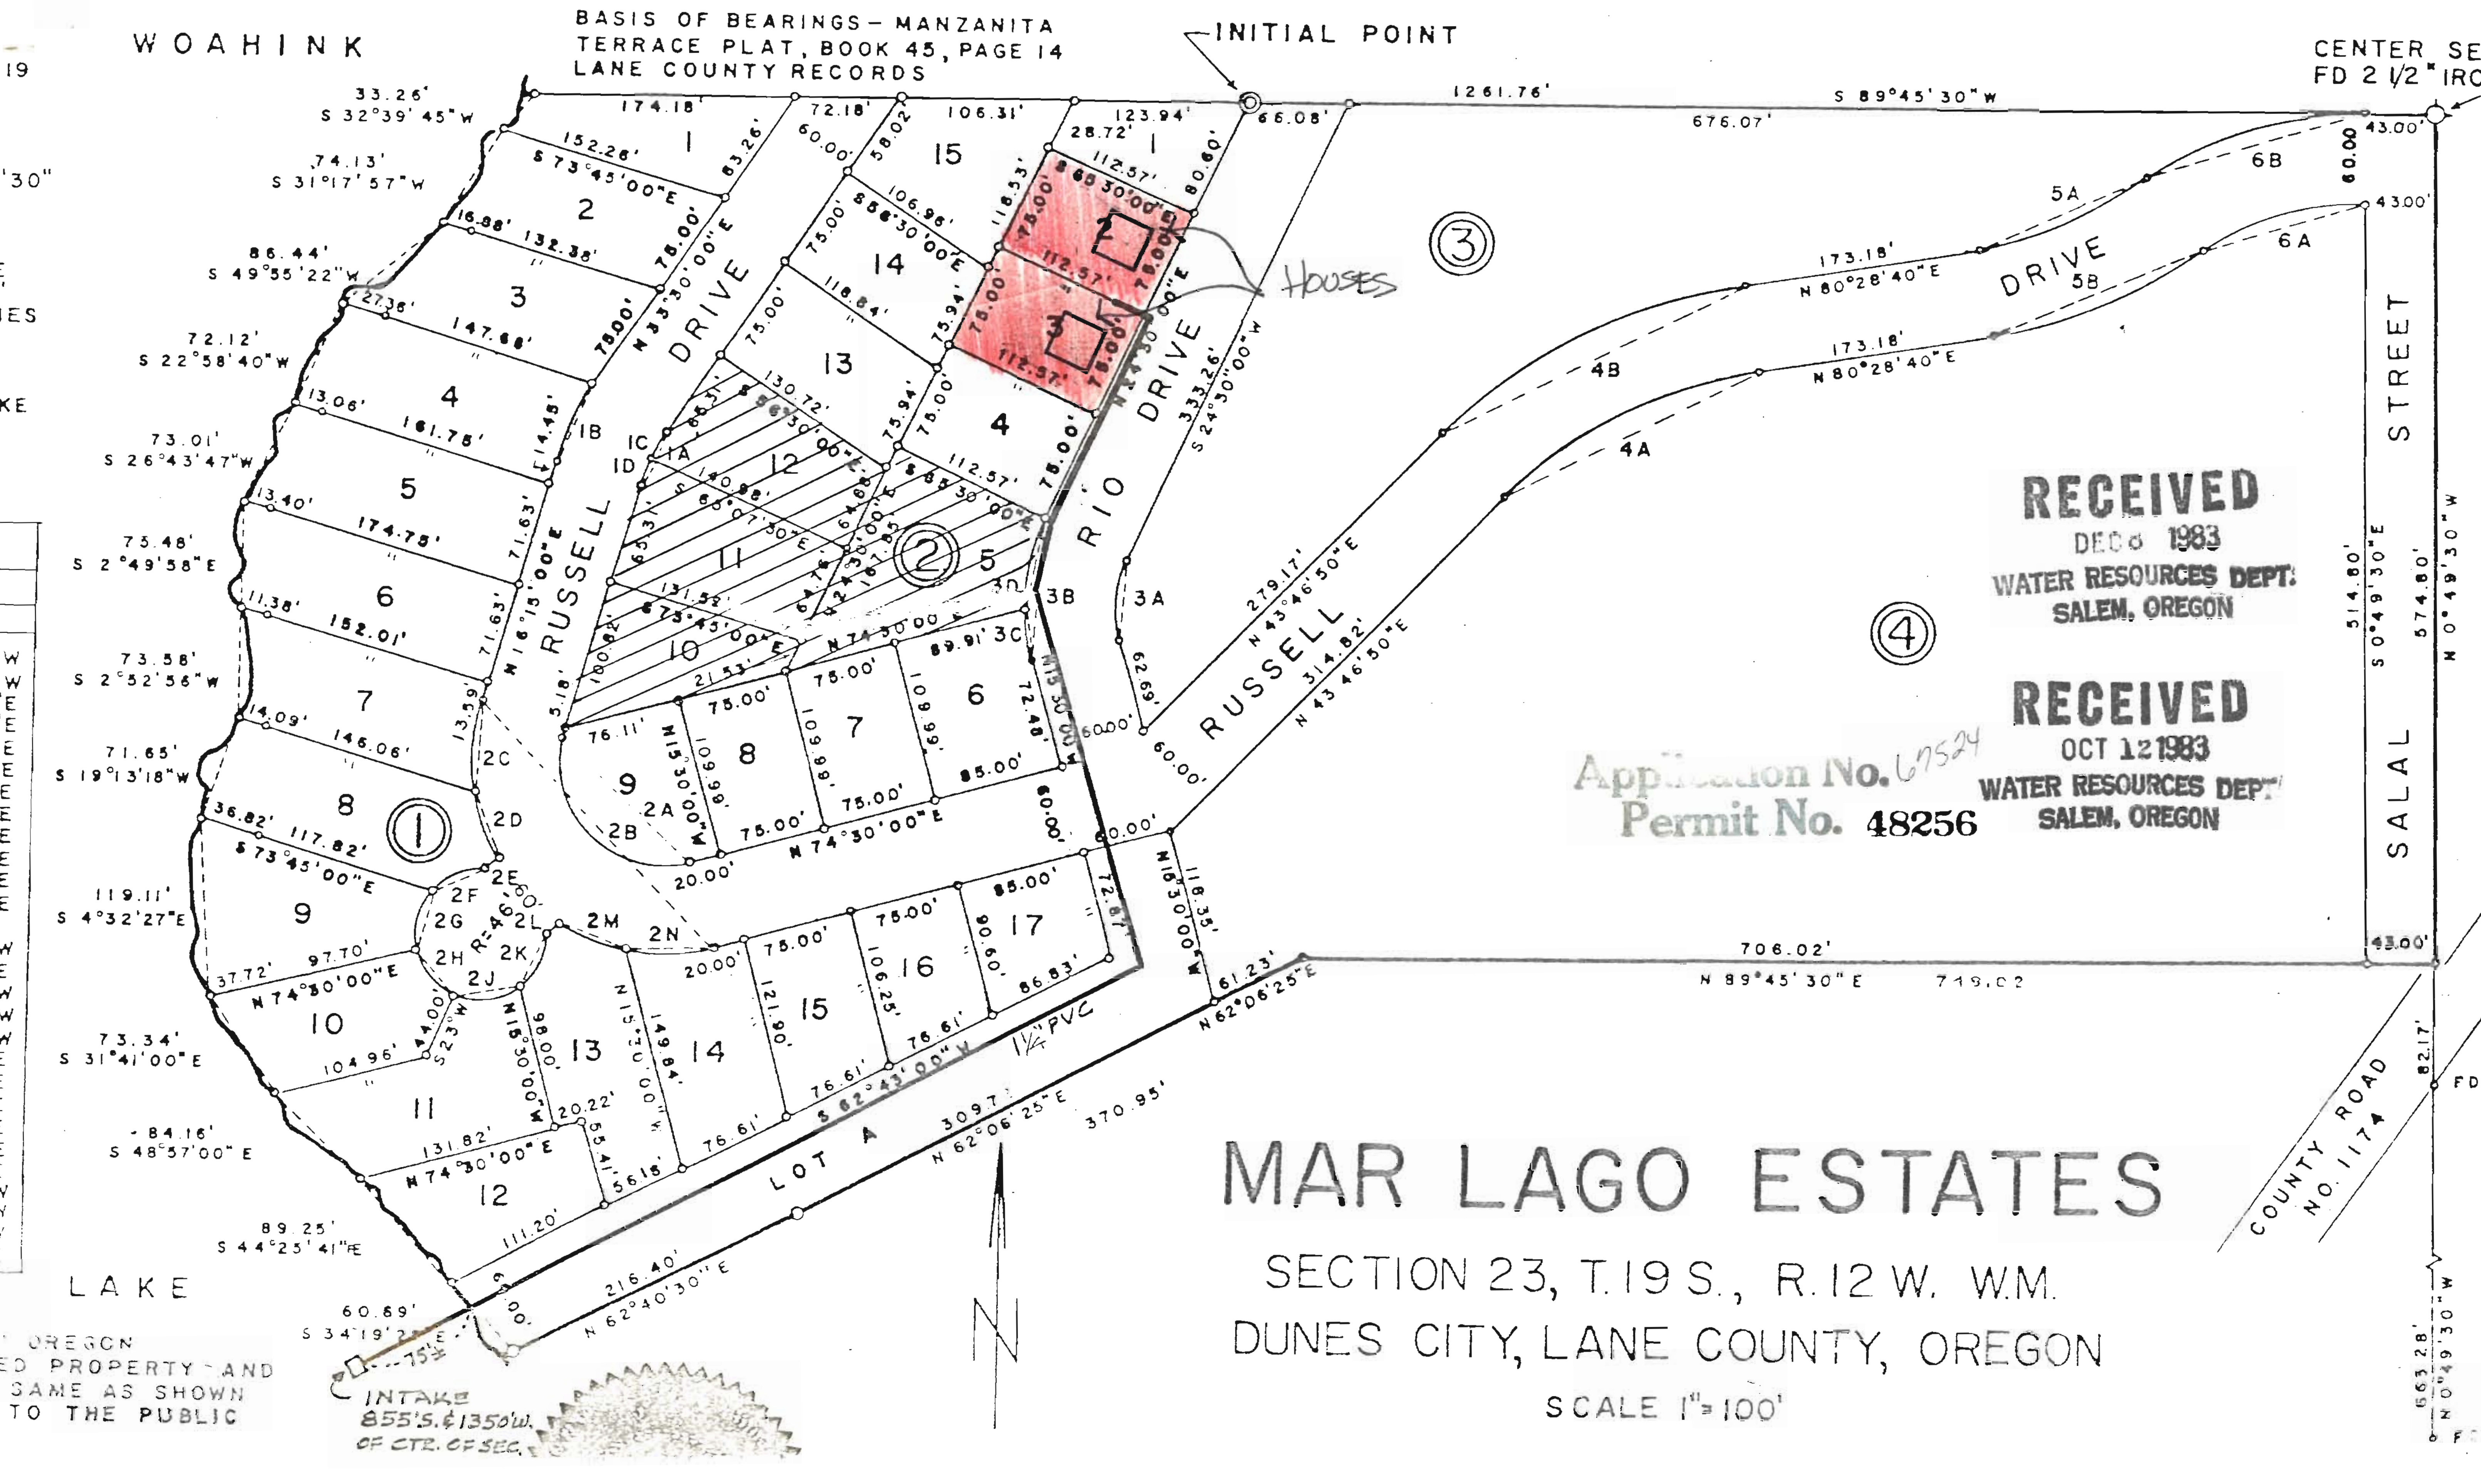

WOAHINK
LAKE
BASIS OF BEARINGS— MANZANITA TERRACE PLAT, BOOK 45, PAGE 14 LANE COUNTY RECORDS
INITIAL POINT
CENTER SEC
FD 2 1/2" IRON
1261.76'
S 89°45'30"W
676.07'
RUSSELL DRIVE
RIO DRIVE
RUSSELL
DRIVE
SALAL STREET
LOT A
COUNTY ROAD NO. 117A
HOUSES
1 1/4" PVC
INTAKE
855'S. & 1350'W.
OF CTR. OF SEC.
706.02'
N 89°45'30"E
N 62°06'25"E
N 62°40'30"E
N 43°46'50"E
RECEIVED
DEC 6 1983
WATER RESOURCES DEPT.
SALEM, OREGON
RECEIVED
OCT 12 1983
WATER RESOURCES DEPT.
SALEM, OREGON
Application No. 67524
Permit No. 48256
MAR LAGO ESTATES
SECTION 23, T.19 S., R.12 W. W.M.
DUNES CITY, LANE COUNTY, OREGON
SCALE 1"= 100'