


T. 27 S., R. 2 W., W. M.

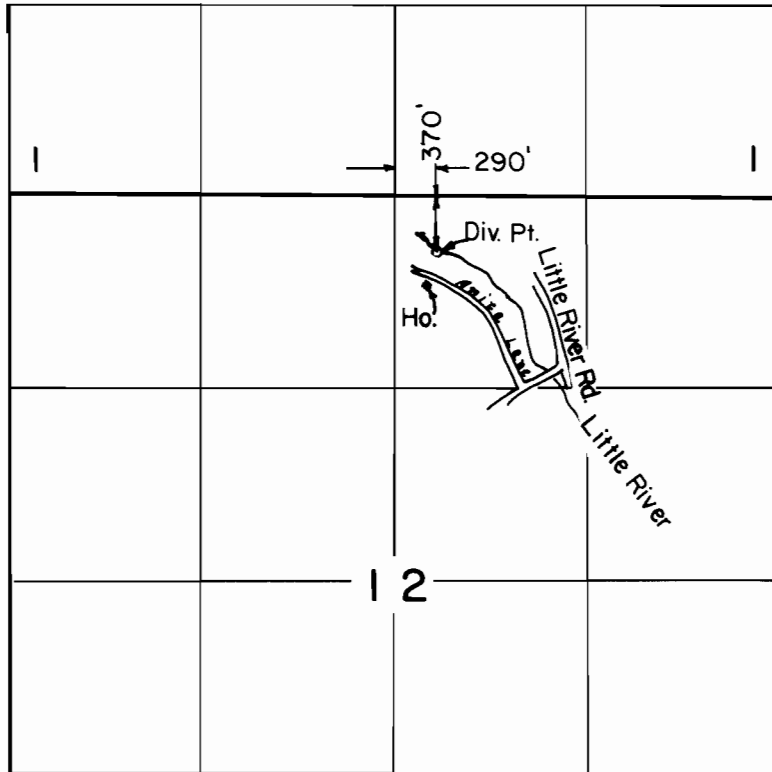

Scale: 1" = 1320'

FINAL PROOF SURVEY
UNDER

Application No. 68078 Permit No. 48487.....
IN NAME OF

.....LARRY D. COLE.....

Surveyed AUG. 27. 1991., by B. S. JAMES.....