


T.22S., R.5 W., W.M.

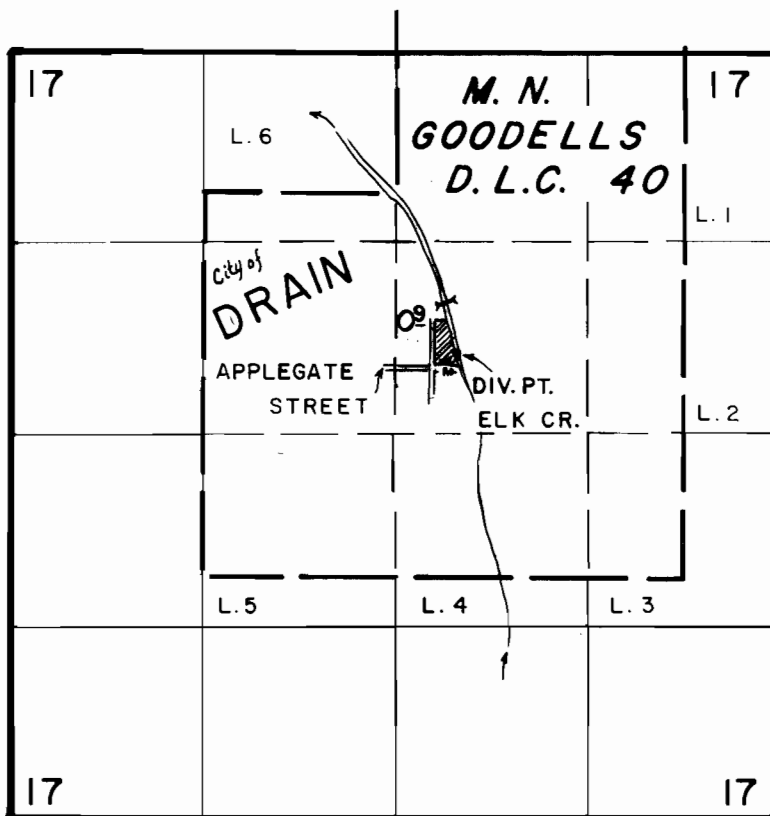

DIV. PT. LOCATION: 530' NORTH and 450' EAST FROM THE CENTER QUARTER CORNER, SEC. 17.

SCALE: 1" = 1320'



FINAL PROOF SURVEY UNDER

Application No. 68805 Permit No. 49772
IN NAME OF

.....JACOB H. SAWYERS.....

Surveyed Sept. 13, 1990, by B. Sue James.....