

Robert Dietlein

RECEIVED

RECEIVED RECEIVED

FEB 1 1988

APR 11 1988


AUG 12 1987

WATER RESOURCES DEPT.  
SALEM, OREGON

WATER RESOURCES DEPT.  
SALEM, OREGON

WATER RESOURCES DEPT.  
SALEM, OREGON

North ↑

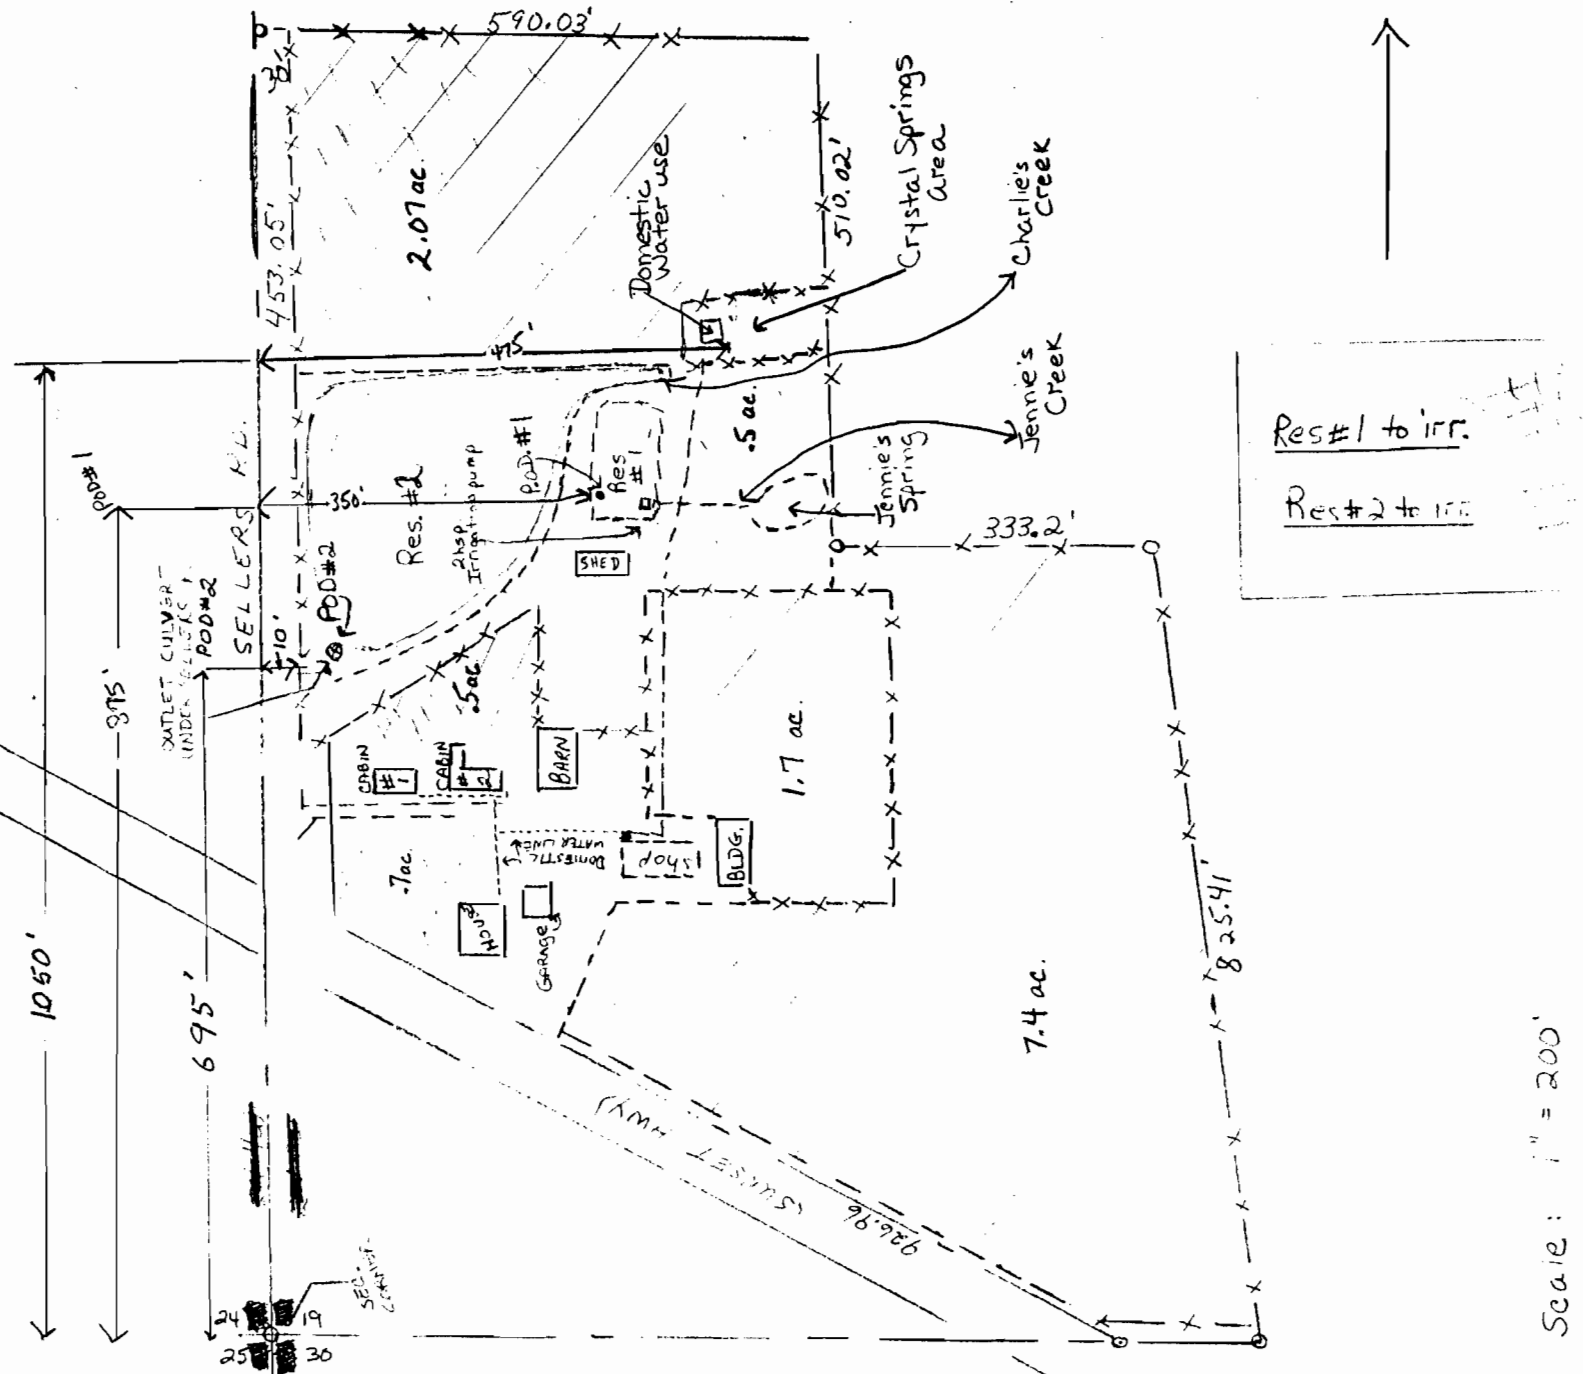

Res #1 to irr.

Res #2 to irr.

Tp. 2N, R. 3W, Sec. 19  
SW corner of sec. 19

Application No. R-69111 & 69112  
Permit No. R10985 50259

Scale: 1" = 200'