


SEE MAP
2N 4 24

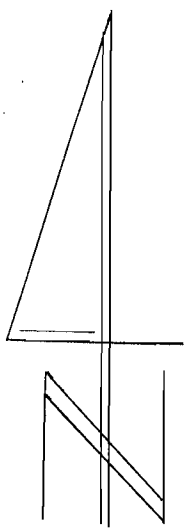

1" = 400'

PROOF SURVEY

UNDER

R69111 R10905
69112 Permit No. 50259

IN NAME OF

BERT P. DIETLEIN

25.19.91, by R W KLASSEN

SEE MAP
2N 3 30