

T.31S., R.15W., W.M.

SECTION 11


FINAL PROOF SURVEY

UNDER

APPLICATION NO. 69280 PERMIT NO. 50153

MELBA L. DELL

REGISTERED
MAY 24 1991
WATER RIGHTS DIVISION
SALEM, OREGON

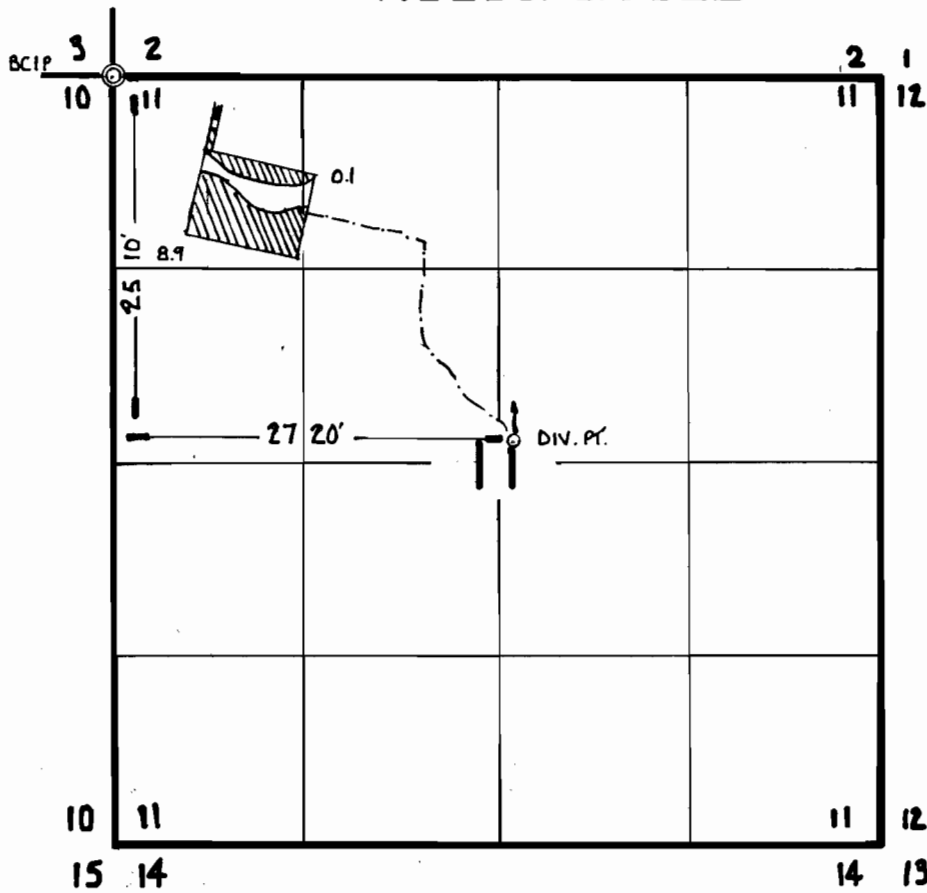

SURVEYED MAY 29, 1991 BY: CLWRE # 107

